


15D025  
LPG SURGE  
DRUM


15E024A/B  
LPG VAPORIZER

15D024  
FUEL GAS  
MIXING DRUM

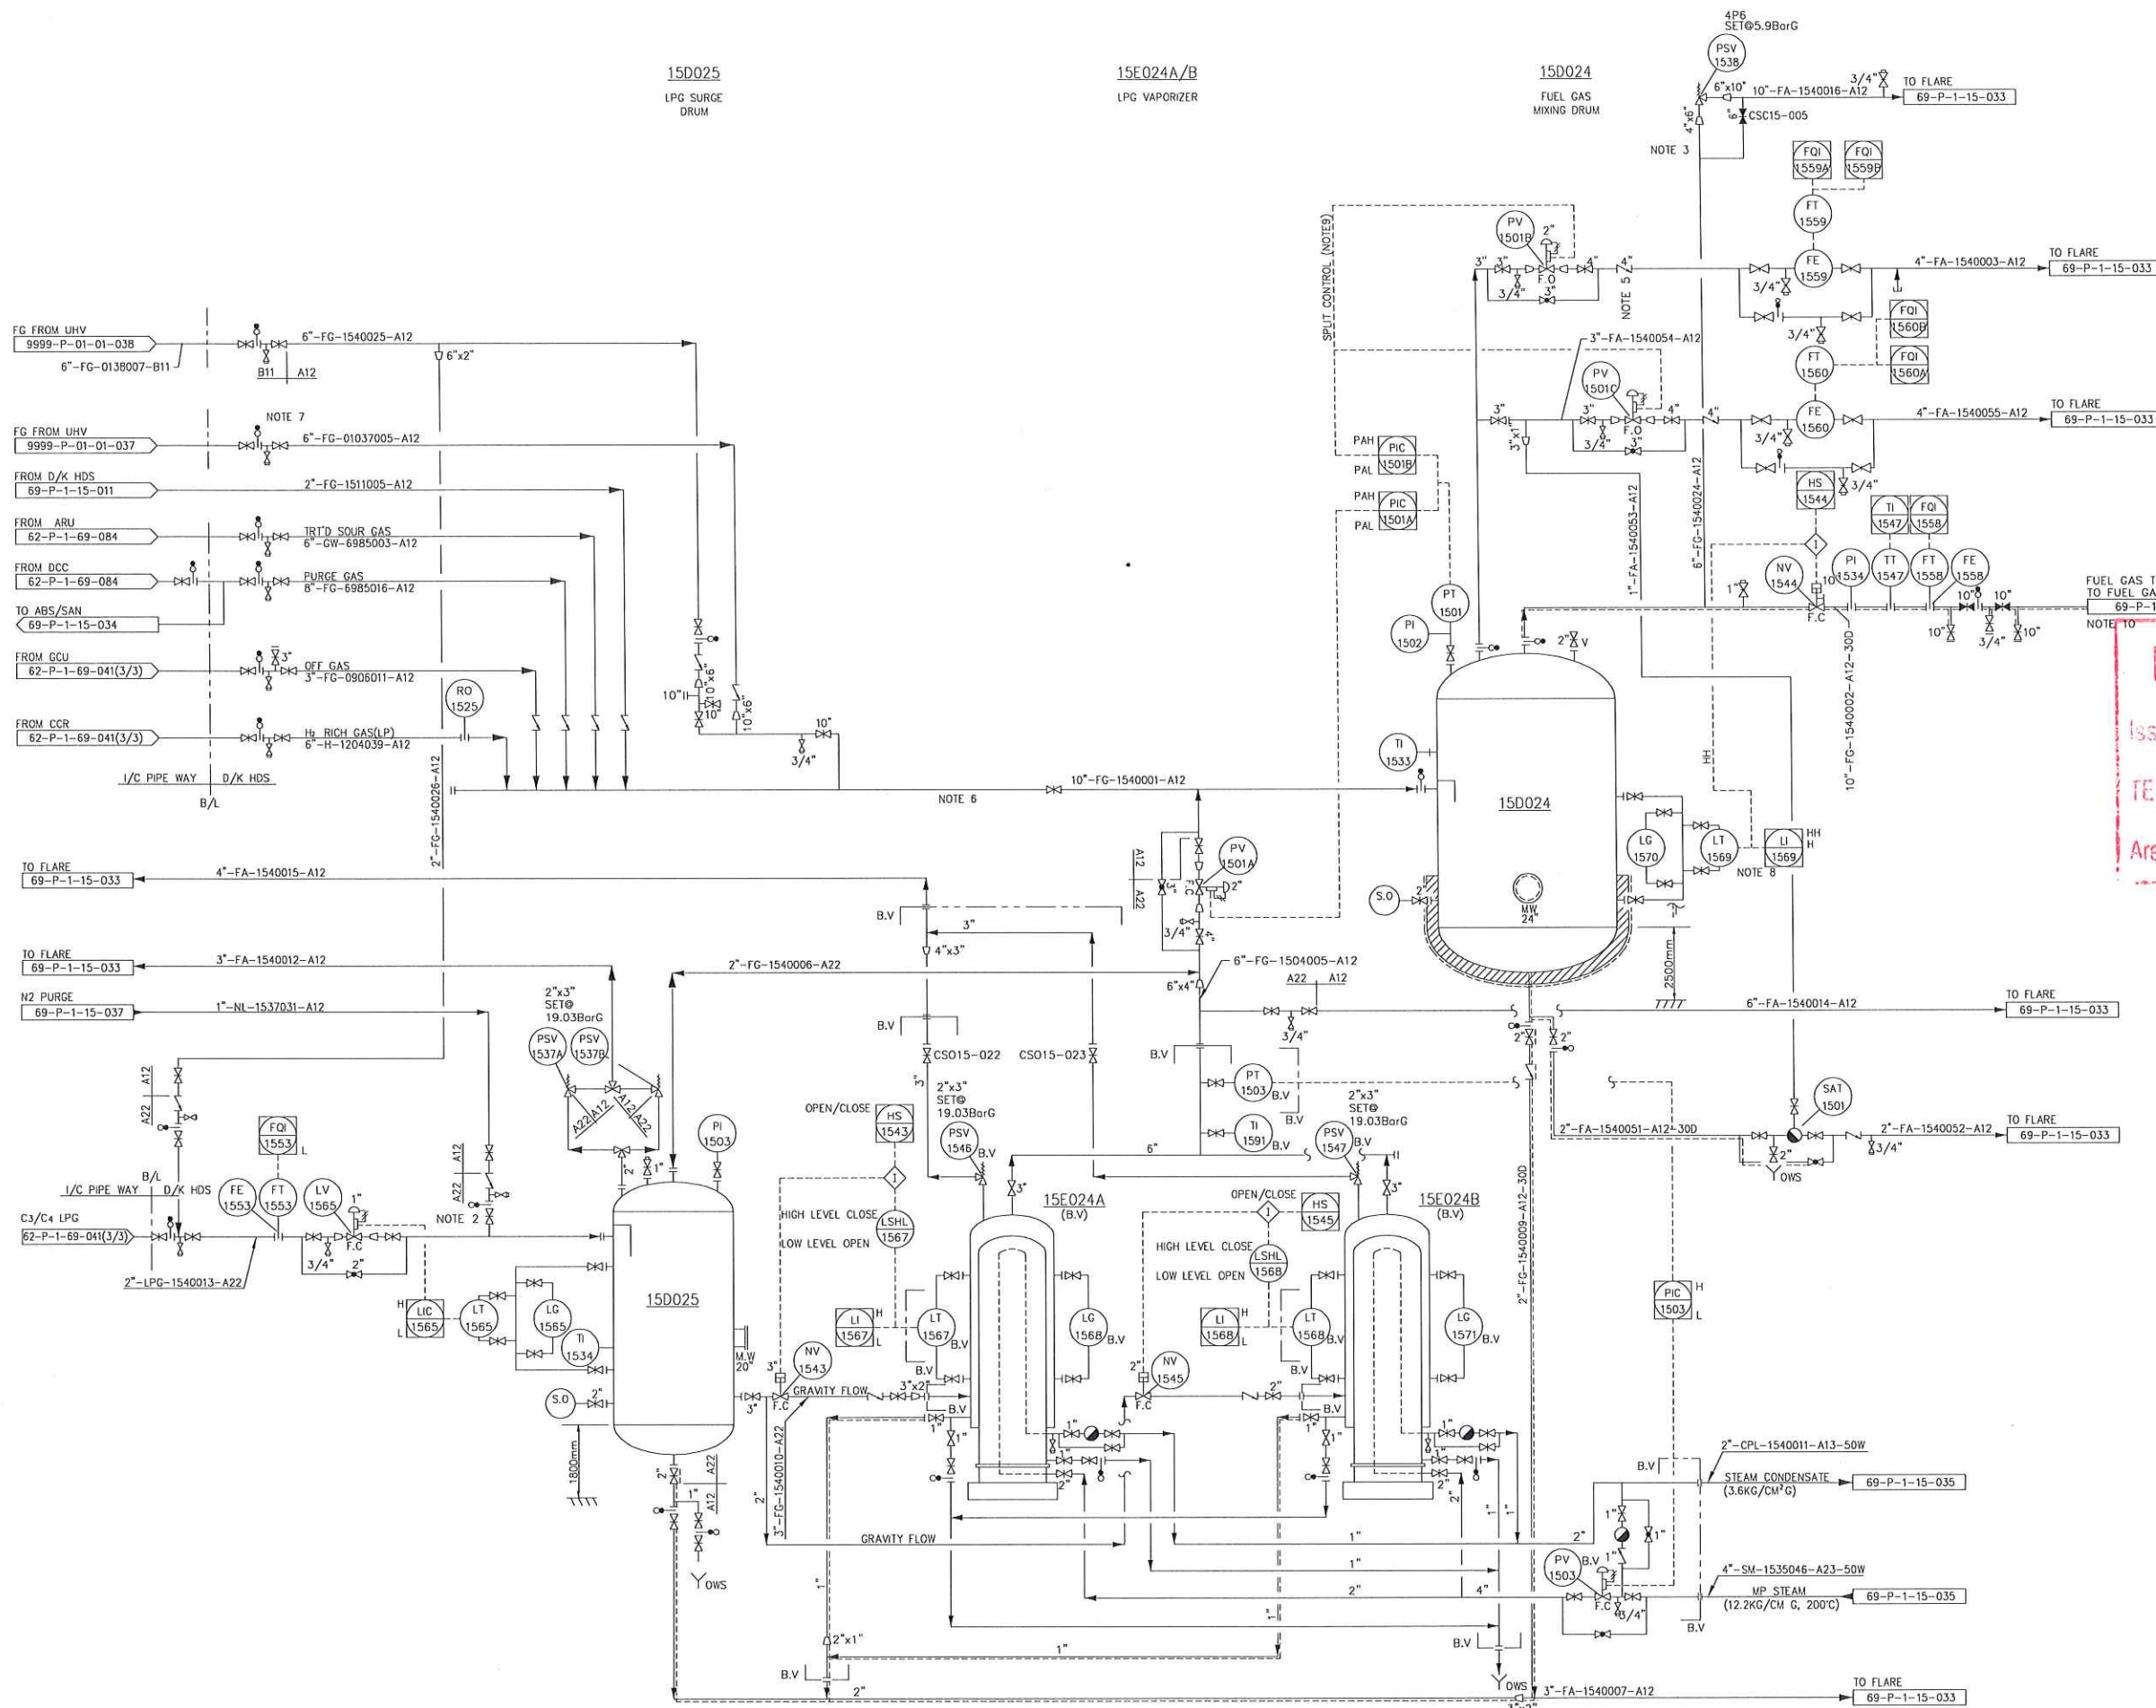

#### NOTE

1. DELETED.
2. CONNECTION FOR N2 PURGE.
3. INCREASE ORIFICE SIZING.
4. DEMOLISH.
5. SOCKET WELD CAP.
6. EN SHALL REVIEW SUPPORT OF THIS PIPE.
7. PROVIDE PLATFORM FOR OPERATE THESE VALVE.
8. CHANGE FROM LSHH 1569 TO LT 1569.
9. ONE CONTROL VALVE WILL OPEN WHEN ANOTHER ONE IS FULL OPEN.

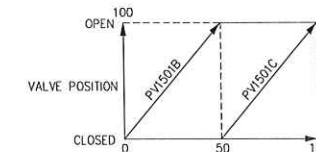

10. 6"-FG-6984001 TO 12D008 (NTU)
- 6"-FG-0008102 TO 01D004/01D008 (ADU1)
- 10"-FG-4113001 TO 41D014 (ADU2)
- 3"-FG-0051002 TO SRU
- 3"-FG-0051001 TO PILOT FLARE

**P&ID AS Built 2021**

Issued..... Date **28 JUN 2021**  
TE Approved..... Date **28 JUN 2021**  
Area Approved..... Date **29 JUN 2021**

REV.	DATE	DESCRIPTION	DRWN	CHKD	APPD	APPD
20	06/22/21	UPDATE 2021	NR	KTN		
19	07/11/19	UPDATE 2019	NR	KTN		
18	08/02/18	UPDATE 2018	NR	ANP		
17	03/05/18	MAXIMIZE UHV'S FUEL GAS	NR	ANP		
16	09/05/17	UPDATE 2017	NR	ANS		
15	10/20/16	UHV FUEL GAS MANAGEMENT	NR	ANP		
14	09/09/16	UPDATE 2016	NR	ANS		
13	03/05/15	UPDATE 2015	NR	ANS		
12	07/02/14	NATURAL GAS PROJECT	NR	ANS		
11	06/03/12	UPDATE 2012	NR	ANS		
10	07/01/11	TIE-IN FOR NG SYSTEM	NR	ANS		
9	03/03/11	INSTALL MASS FLOW	NR	ANS		
8	01/31/11	CHANGE SPLITE RANGE TO INDIVIDUAL	NR	NCR		
7	03/14/08	UPDATE 2008	JRW	TN		
6	26/12/07	FG SUPPLY TO TABS	CNR			
5	06/30/03	INCREASE ORIFICE SIZING	NR			
4	9/10/02	UPDATE 2002	NR			

IRPC						
IRPC PUBLIC COMPANY LIMITED						
TPI SPLITTER PLANT PHASE III PROJECT						
RAYONG, THAILAND						
LG Engineering Co., Ltd.						
PIPING & INSTRUMENT DIAGRAM						
FOR FUEL GAS SYSTEM						
SQUAD CHECK						
PROCESS PIPING VESSELS STRUCT. ELEC. INST.						
DWG. NO. 69-P-1-15-040-3-20						
SCALE NONE JOB NO. 8816 MICROFILM NO.						