


NOTES:

- SEE LEGEND AND SYMBOLS DRAWINGS.
- INSTRUMENT NUMBERING ON P&ID SHEETS ARE COMPOSED OF IDENTIFICATION LETTERS, PLANT UNIT NUMBER AND RUNNING NUMBER.
- TW AND PP FOR EXCHANGER SHALL BE INSTALLED ACCORDING TO TEMA CLASS.

ITEM NO.	TW TAG. NO.
15E020	TW-1516A/B/C
15E021	TW-1517A/B

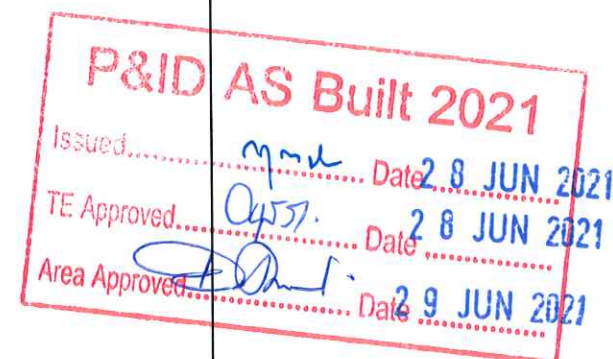

REV.	DATE	DESCRIPTION OF ISSUE	DRWN	CHKD	APPD	APPD	APPD
03-14-08		UPDATE 2008	JRW	TN			
12-31-96		AS BUILT					
11-03-95		REVISED AS MARKED	YSJ	JHS	BYJ	JWL	
08-12-95		F.F.C	YSJ	JHS	BYJ	JWL	
03-31-95		A.F.D	YSJ	JHS	BYJ	JWL	
02-08-95		FOR APPROVAL	TCM	HBS	LEE		



IRPC PUBLIC COMPANY LIMITED

TPI SPLITTER PLANT PHASE III PROJECT
 RAYONG, THAILAND



LG Engineering Co., Ltd.
 SEOUL, KOREA



TETRA ENGINEERING & TECHNOLOGY INC.
 BREA, CALIFORNIA, U.S.A.

D/K HDS UNIT PIPING & INSTRUMENT DIAGRAM
 DRYER EJECTORS & CONDENSERS

JOB NUMBER	DRAWING NUMBER	REV. NO.
8816	69-P-1-15-023-3-5	5