


NOTES:

- SEE LEGEND AND SYMBOLS DRAWINGS.
- DELETED.
- CONNECTION FOR DRUM PUMP. ONE POTABLE DRUM PUMP TO BE PROVIDED IN WAREHOUSE TO UNLOAD DMDS AND CORROSION INHIBITOR SOLUTION.
- DMDS DRAINS TO CLOSED DRAIN CHEMICALS DO NOT DRAIN TO SEWER.
- OIL DRAIN AFTER FLUSHING.
- INSTRUMENT NUMBERING ON P&ID SHEETS ARE COMPOSED OF IDENTIFICATION LETTERS, PLANT UNIT NUMBER AND RUNNING NUMBER.
- INTERNAL PSV TO BE PROVIDED BY PUMP VENDOR.

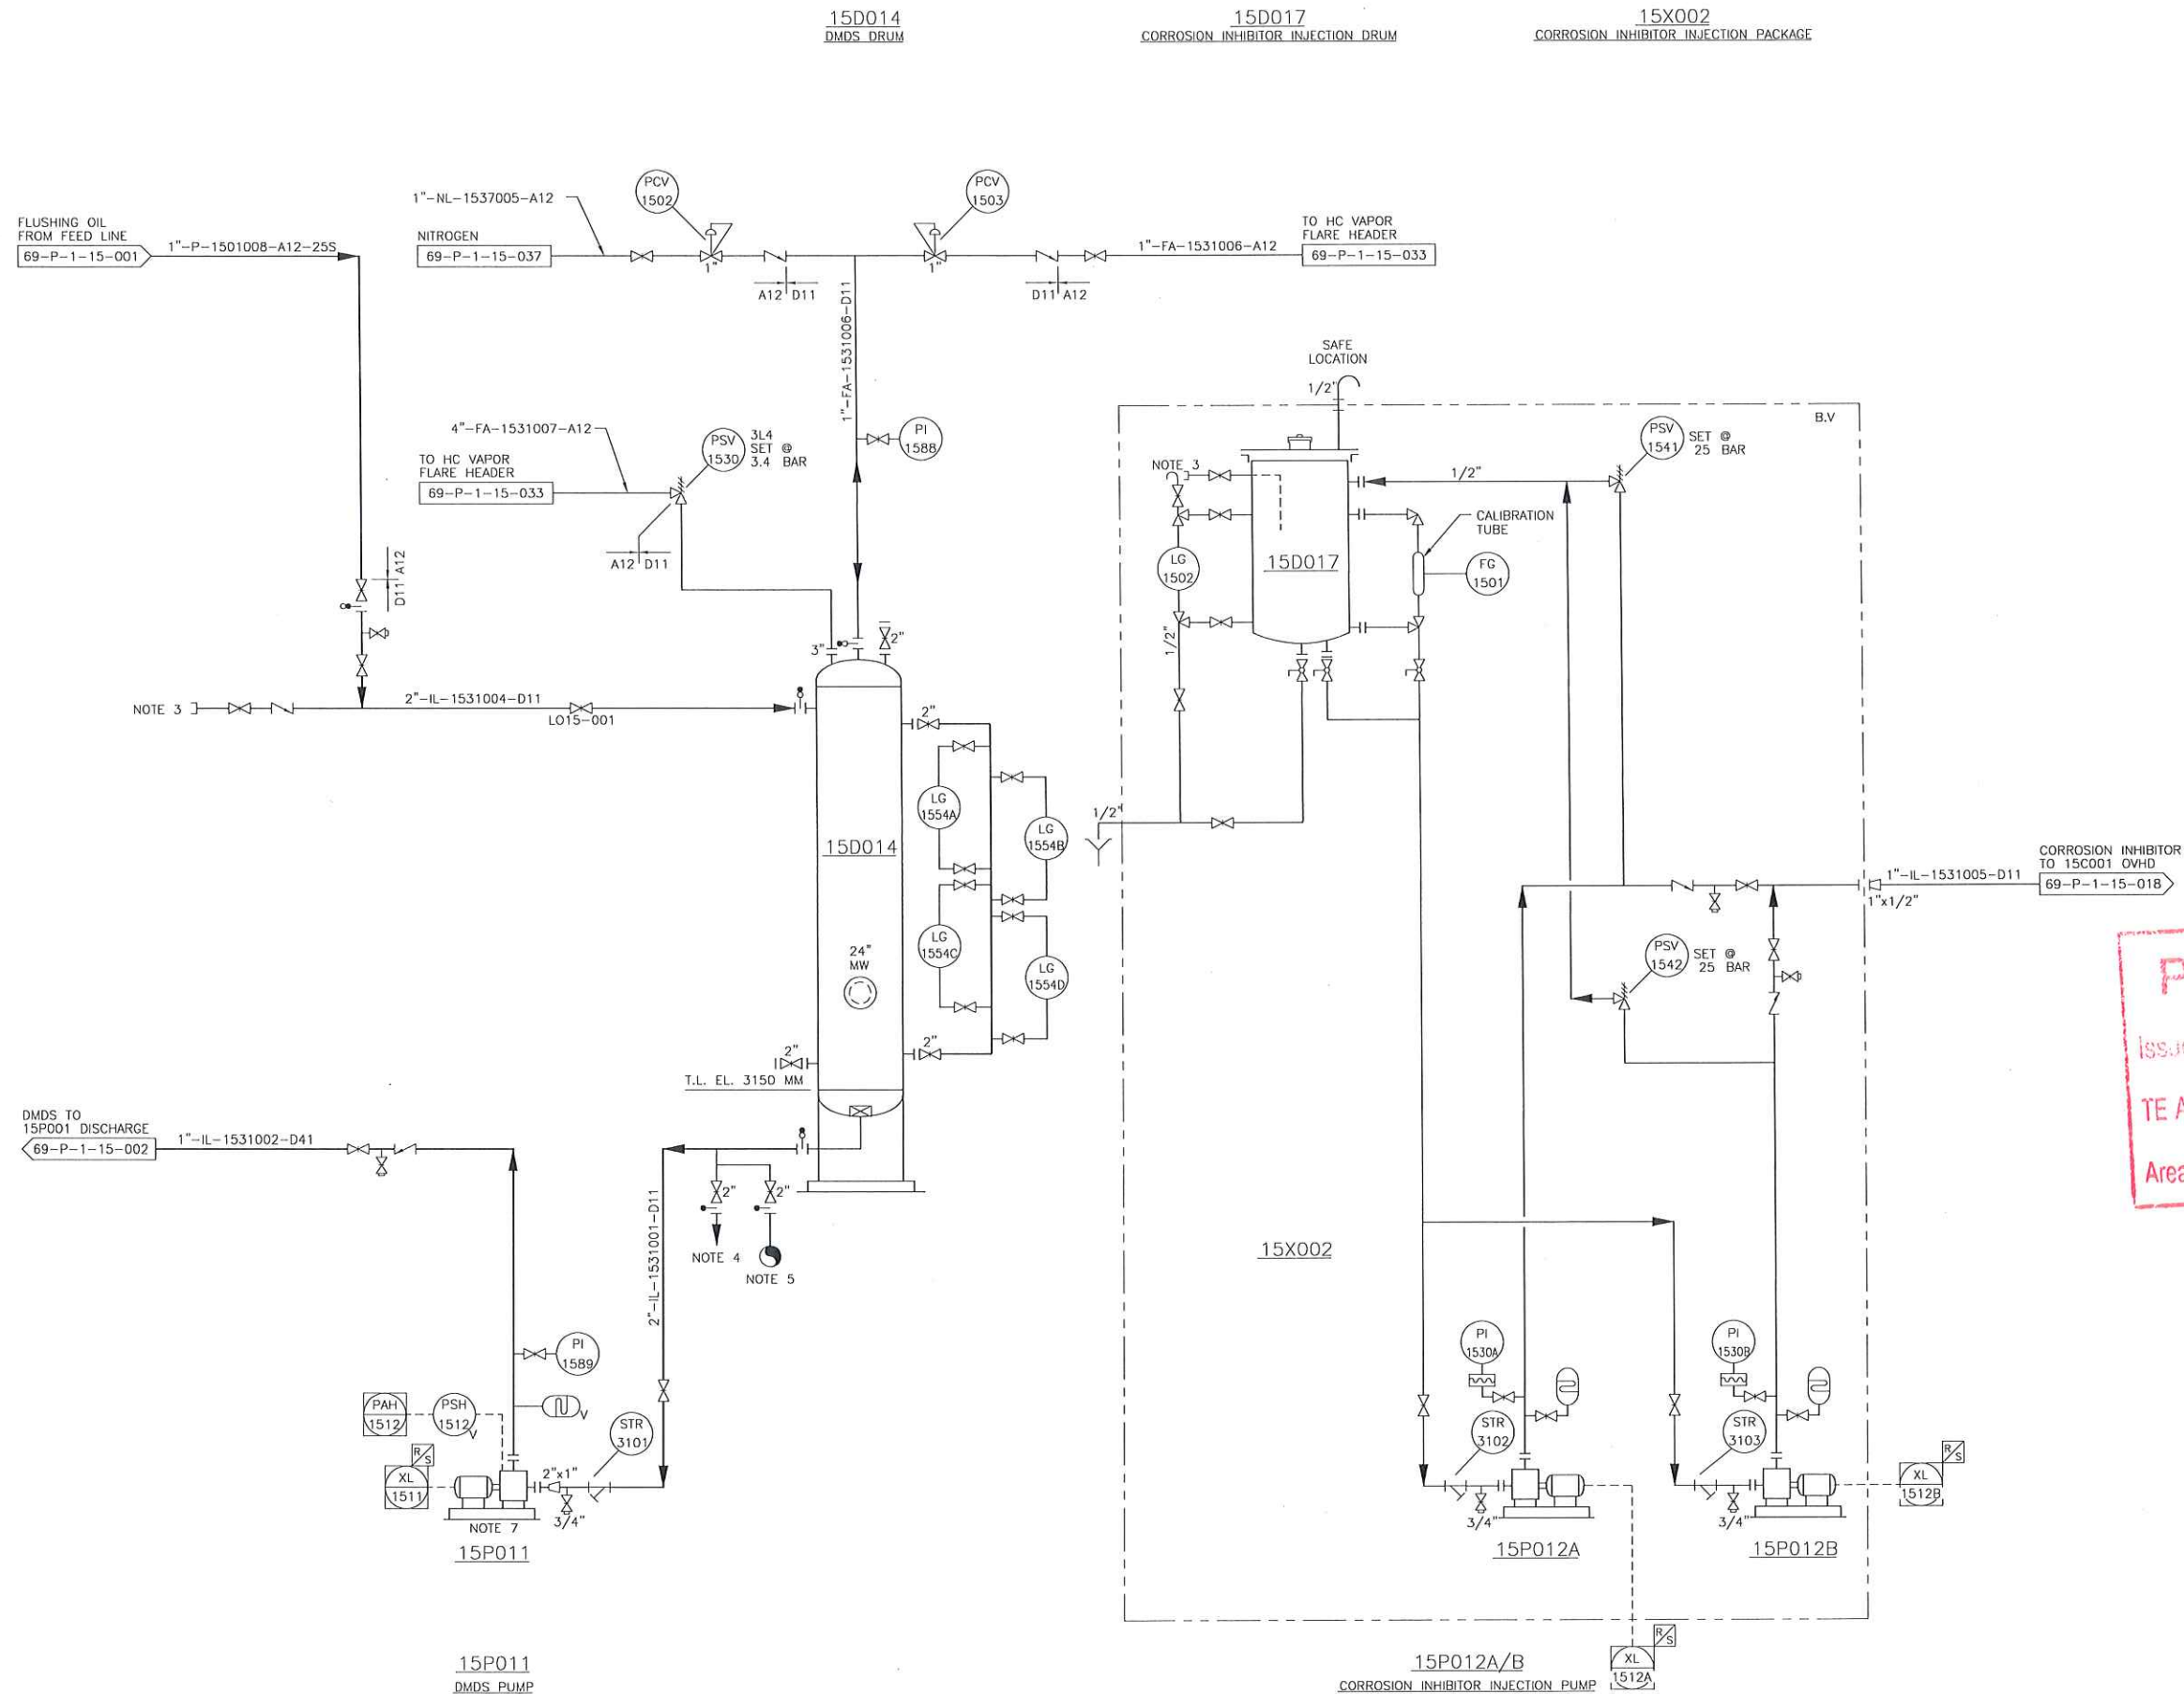

P&ID AS Built 2021

Issued *Ynd* Date **28 JUN 2021**

TE Approved *Qps* Date **28 JUN 2021**

Area Approved *EDW* Date **29 JUN 2021**

REV.	DATE	DESCRIPTION OF ISSUE	DRWN	CHKD	APPD	APPD	APPD
06-22-21		UPDATE 2021	HR	KTW			
03-14-08		UPDATE 2008	JRW	TN			
12-31-98		AS BUILT					
12-30-95		REVISED AS MARKED	YSJ	JHS	BYJ	JVL	
11-03-95		REVISED AS MARKED	YSJ	JHS	BYJ	JVL	
08-12-95		F.F.C	YSJ	JHS	BYJ	JVL	
03-31-95		A.F.D	YSJ	JHS	IKK	YSK	GHK
02-08-95		FOR APPROVAL	TCM	HBS	LEE		

IRPC IRPC PUBLIC COMPANY LIMITED TPI SPLITTER PLANT PHASE III PROJECT RAYONG, THAILAND		
LG Engineering Co., Ltd. SEOUL, KOREA		
TETRA ENGINEERING & TECHNOLOGY INC. BREA, CALIFORNIA, U.S.A.		
D/K HDS UNIT PIPING & INSTRUMENT DIAGRAM CHEMICAL SYSTEMS DMDS & CORROSION INHIBITOR		
JOB NUMBER	DRAWING NUMBER	REV. NO.
8816	69-P-1-15-031-3-7	7