


SYMBOL & LEGEND

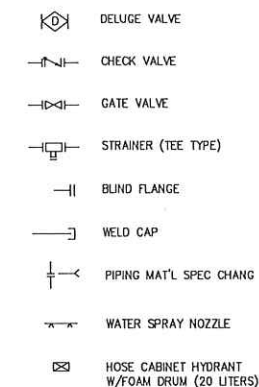


ABBREVIATION

DV	DELUGE VALVE
HS	HAND SWITCH
HC	HOSE CABINET HYDRANT
PA	PRESSURE ALARM
PG	PRESSURE GAUGE
PS	PRESSURE SWITCH
STR	STRAINER
WF	FIRE WATER
N.C.	NORMAL CLOSE
N.O.	NORMAL OPEN


NOTES

1. DRAIN VALVE SHALL BE PROVIDED AT LOWEST POINT.

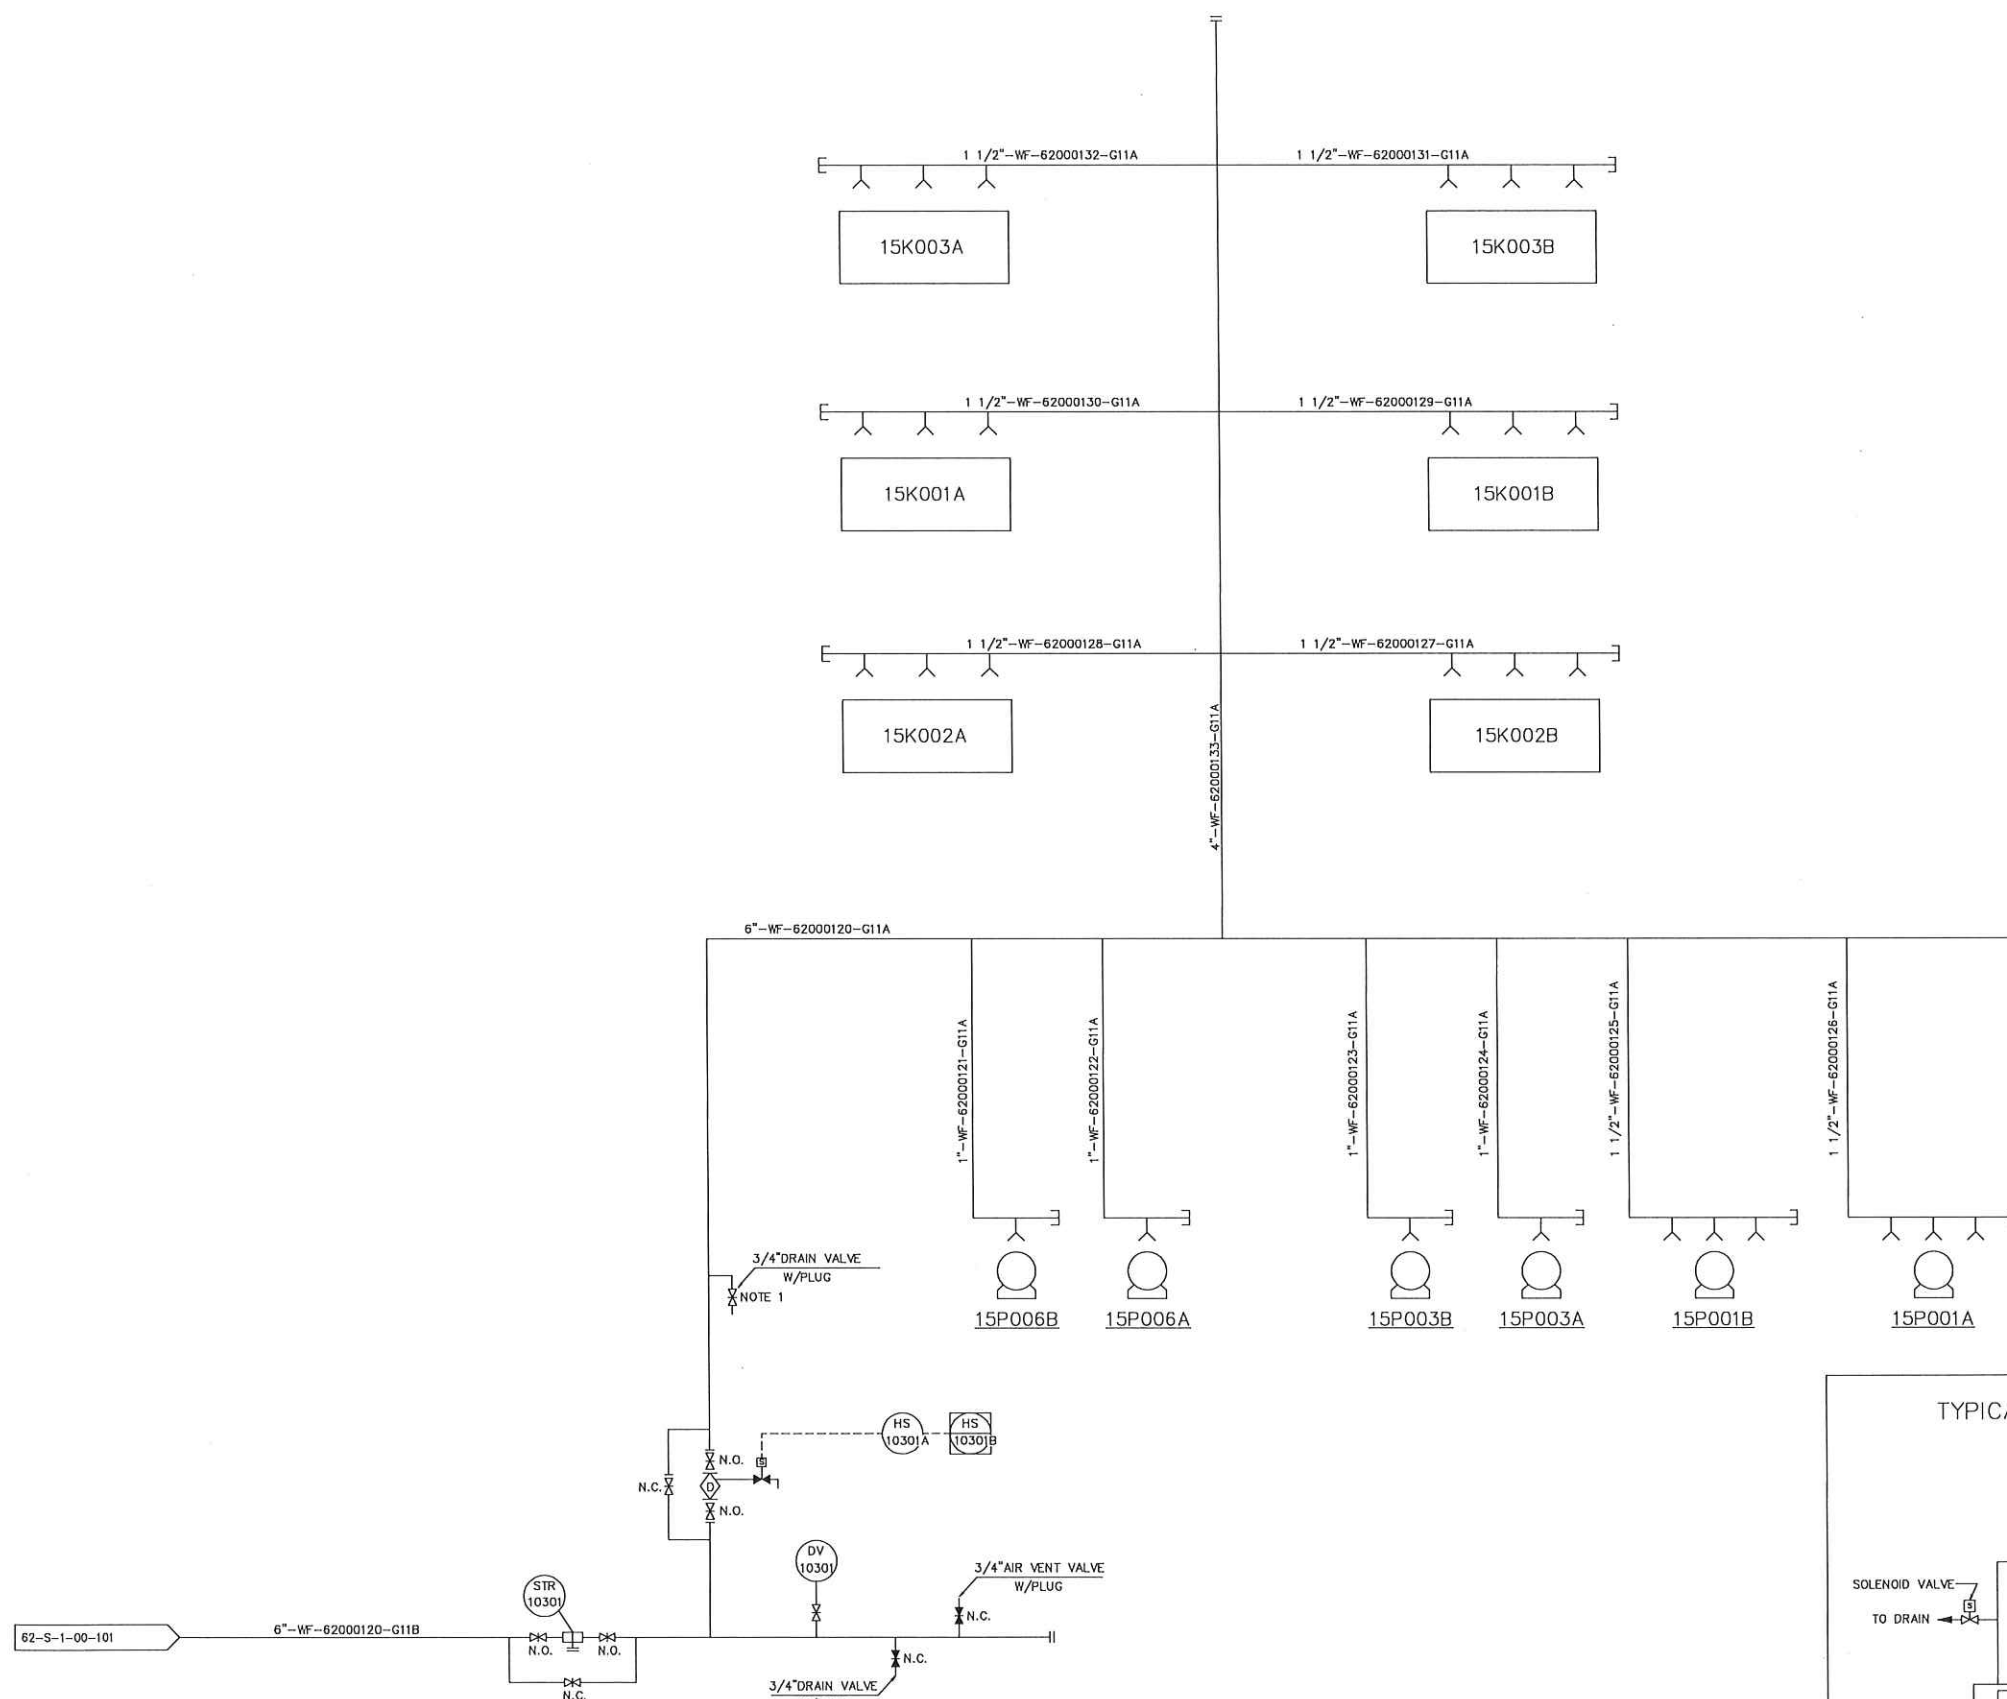

ID	NOZZLE TYPE	NOZZLE SIZE (in)	FLOW RATE (lpm)	SPRAY ANGLE (Deg.)	Q'ty (EA)
15P001A/B	FULL CONE	1/2	106	120	3
15P003A/B	FULL CONE	1/2	106	120	1
15P006A/B	FULL CONE	1/2	106	120	1
15K001A/B	FULL CONE	1/2	106	120	2
15K002A/B	FULL CONE	1/2	106	120	4
15K003A/B	FULL CONE	1/2	106	120	2

TYPICAL DETAIL FOR DELUGE V/V

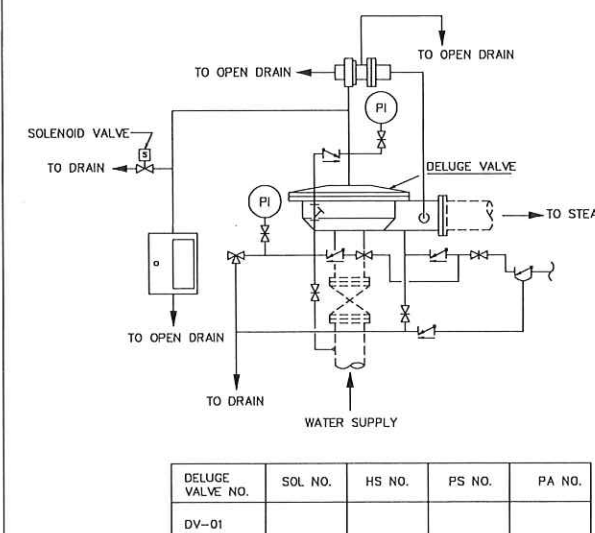

P&ID AS Built 2021

Issued..... Date **28 JUN 2021**
 TE Approved..... Date **28 JUN 2021**
 Area Approved..... Date **29 JUN 2021**

REV.	DATE	DESCRIPTION	DRAWN	DESIGNED	CHECKED	APPROVED
14/03/08		UPDATE 2008	NR	TN		
10/02/06			JRW	GR		

irpc
 IRPC PUBLIC COMPANY LIMITED

DESCRIPTION
 P&ID FOR
 FIRE WATER SPRAY SYSTEM (DK)

PROJECT NO.	
DWG NO.	62-S-1-00-103-3-1
SCALE:	NONE
JOB NO.	
PAGE	0/0
REV.	1