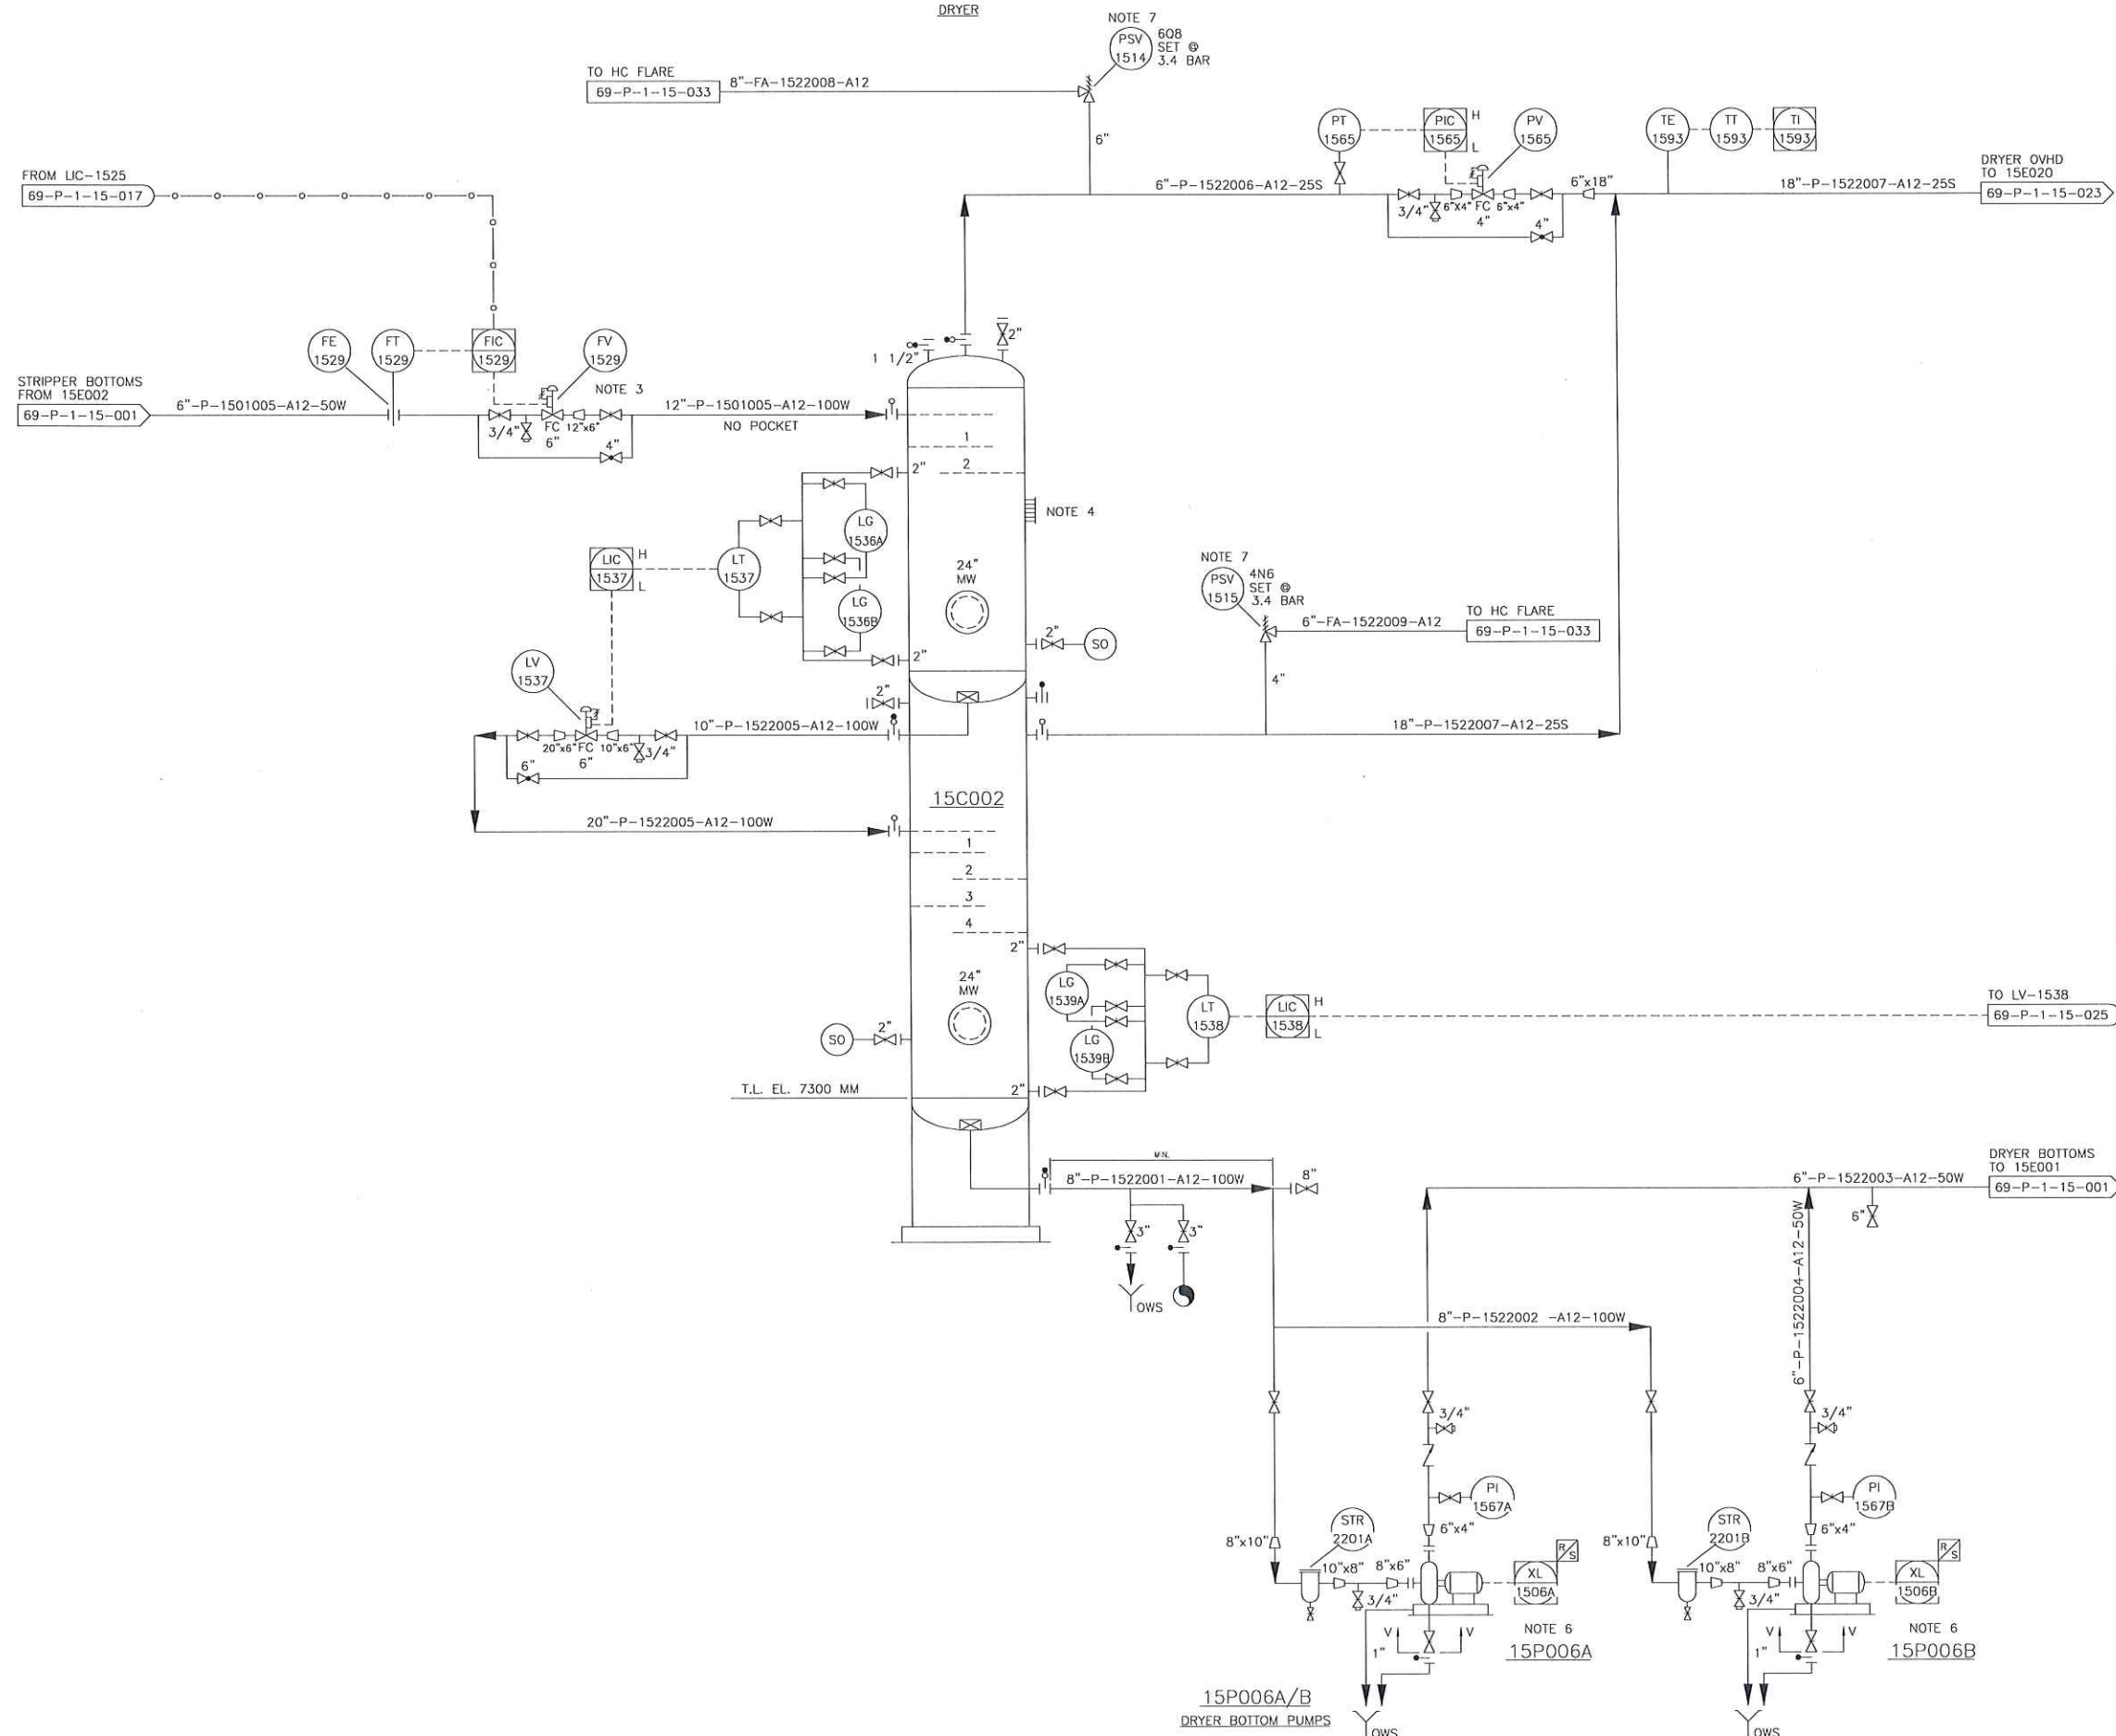


15C002
DRYER

NOTES:

- SEE LEGEND AND SYMBOLS DRAWINGS.
- DELETED.
- LOCATE CONTROL VALVE MANIFOLD AT OR ABOVE THE ELEVATION OF INLET NOZZLE WITHIN 10 PIPE DIAMETERS.
- | ITEM NO. | TYPE | THICKNESS (MM) |
|----------|------|----------------|
| 15C002 | HOT | 100 |
- INSTRUMENT NUMBERING ON P&ID SHEETS ARE COMPOSED OF IDENTIFICATION LETTERS, PLANT UNIT NUMBER AND RUNNING NUMBER.
- CHANGE MOTOR AND IMPELLER.
- NEW PSVs REPLACEMENT SHALL BE LOCATED ON PLATFORM.
- DELETED.

P&ID AS Built 2021

Issued... *mmv* Date 28 JUN 2021TE Approved... *Chit* Date 28 JUN 2021Area Approved... *Chit* Date 29 JUN 2021

REV.	DATE	DESCRIPTION OF ISSUE	DRWN	CHKD	APPD	APPD
10	03-13-17	UPDATE 2017	NR	ANS		
9	12-16-16	D/K PSVs REPLACEMENT	NR	ANS		
8	03-14-08	UPDATE 2008	JRW	TN		
7	14-10-05	INSTALL CAR SEAL OPEN VALVE	JRW	GR		
6	06-22-00	MODIFY FOR 120%	JRW	KTC		
5	12-31-96	AS BUILT				
4	12-30-95	REVISED AS MARKED	YSJ	JHS	BYJ	JVL
3	11-03-95	REVISED AS MARKED	YSJ	JHS	BYJ	JVL
2	08-12-95	F.F.C	YSJ	JHS	BYJ	JVL
1	03-31-95	A.F.D	YSJ	JHS	YSK	GHK

irpc IRPC PUBLIC COMPANY LIMITED						
TPI SPLITTER PLANT PHASE III PROJECT RAYONG, THAILAND						
LG Engineering Co., Ltd. SEOUL, KOREA						
TETRA ENGINEERING & TECHNOLOGY INC. BREA, CALIFORNIA, U.S.A.						
D/K HDS UNIT PIPING & INSTRUMENT DIAGRAM DRYER						
JOB NUMBER	DRAWING NUMBER				REV. NO.	
8816	69-P-1-15-022-3-10				10	