


NOTES:

15K001AE01
C.W. ELECTRIC HEATER

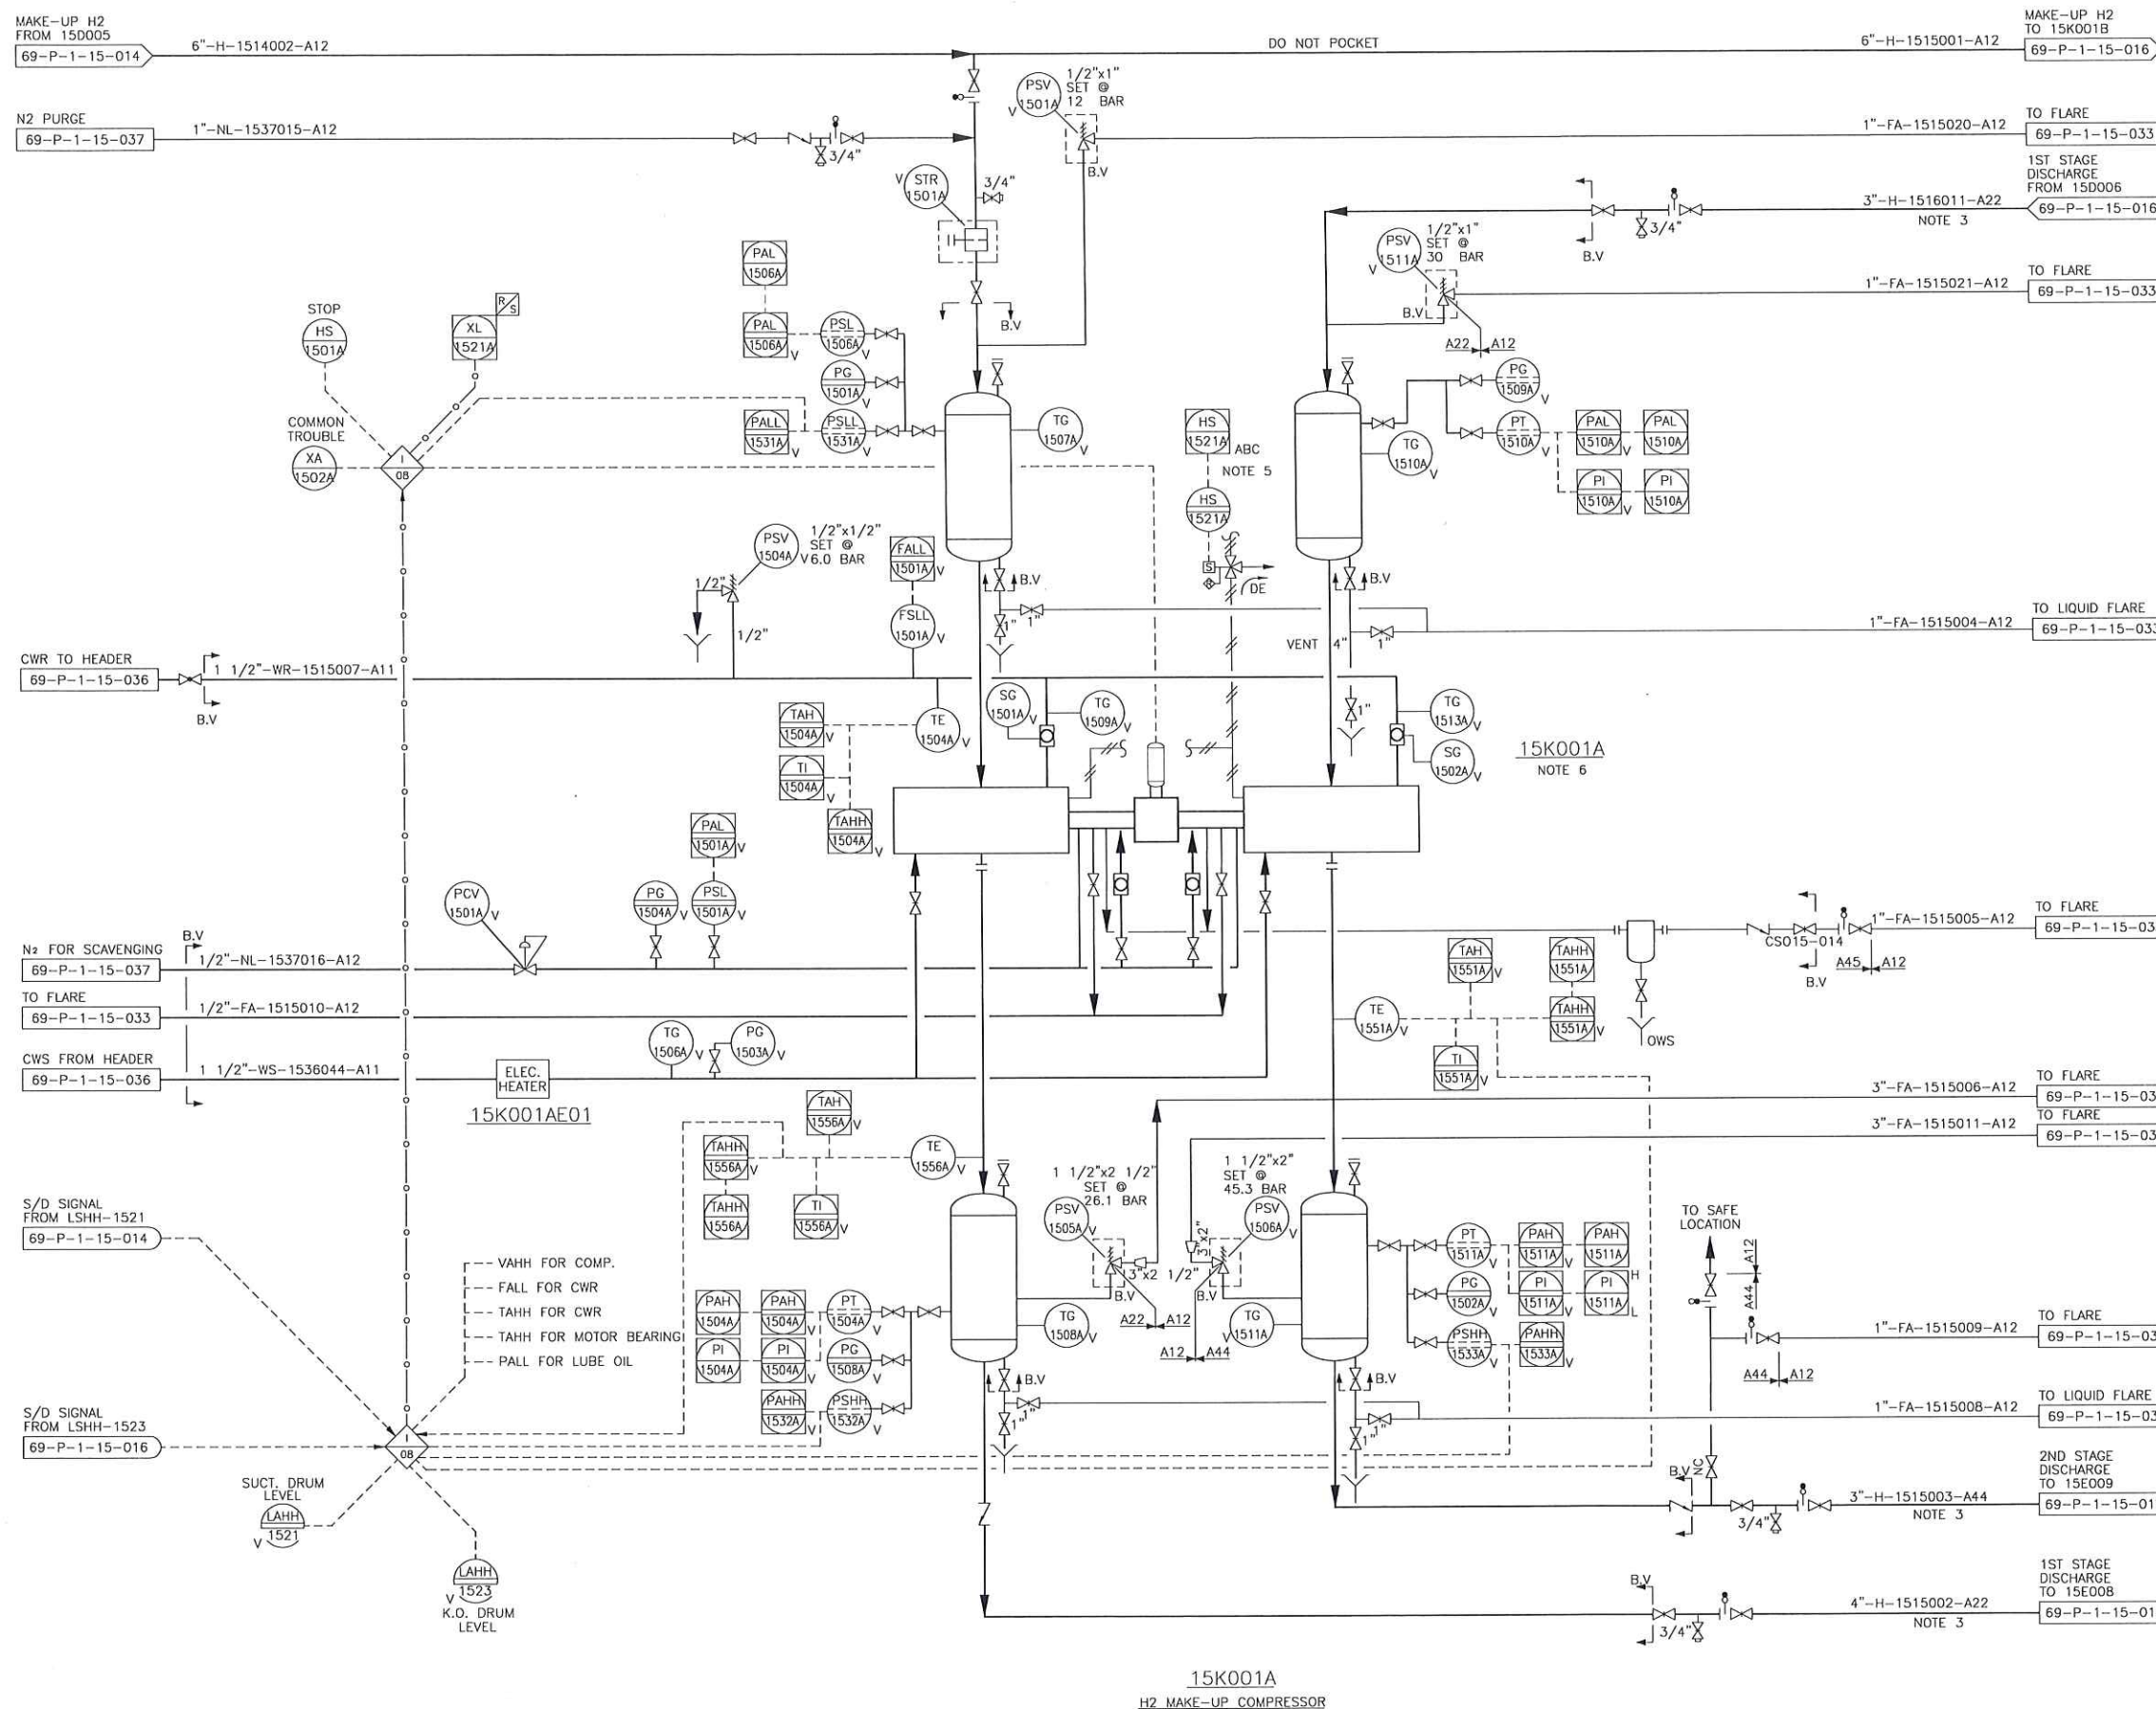

1. SEE LEGEND AND SYMBOLS DRAWINGS.
2. DELETED.
3. INTERCONNECTION PIPING TO BE SIZED BY COMPRESSOR VENDOR.
4. INSTRUMENT NUMBERING ON P&ID SHEETS ARE COMPOSED OF IDENTIFICATION LETTERS, PLANT UNIT NUMBER AND RUNNING NUMBER.
5. 3 STEPS OF UNLOADER CAPACITY CONTROL (0%, 50%, 100%).
6. SEE VENDOR P&ID DWG NO. 15-R-K-01-001 FOR COMPRESSOR MECHANICAL & CONTROL DETAILS.

PAID AS Built 2021

Issued myra Date **28 JUN 2021**

TE Approved C/57 Date **28 JUN 2021**

Area Approved [Signature] Date **29 JUN 2021**

7	06-23-21	UPDATE 2021	NR	KTN			
6	03-14-08	UPDATE 2008	JRW	TN			
5	12-31-96	AS BUILT					
4	01-29-96	REVISED AS MARKED	YSJ	JHS	BTJ	JWL	
3	11-03-95	REVISED AS MARKED	YSJ	JHS	BTJ	JWL	
2	09-07-95	F.F.C	YSJ	JHS	BTJ	JWL	
1	08-12-95	A.F.D	YSJ	JHS	BTJ	JWL	
0	02-08-95	FOR APPROVAL	TCM	HBS	LEE		
REV.	DATE	DESCRIPTION OF ISSUE	DRAWN	CHKD	APPD	APPD	AF

irpc

IRPC PUBLIC COMPANY LIMITED

TPI SPLITTER PLANT PHASE III PROJECT
RAYONG, THAILAND
LG Engineering Co., Ltd.
 SEOUL, KOREA

 TETRA ENGINEERING &
TECHNOLOGY INC.
BREA, CALIFORNIA, U.S.A.

D/K HDS UNIT PIPING & INSTRUMENT DIAGRAM
H2 MAKE-UP COMPRESSOR
15K001A

JOB NUMBER	DRAWING NUMBER	REV. NO.
8816	69-P-1-15-015-3-7	7