


NOTES:

1. SEE LEGEND AND SYMBOLS DRAWINGS.
2. SEE DWG NO. 69-P-1-15-004.
3. DELETED.
4. INSTRUMENT NUMBERING ON P&ID SHEETS ARE COMPOSED OF IDENTIFICATION LETTERS, PLANT UNIT NUMBER AND RUNNING NUMBER.

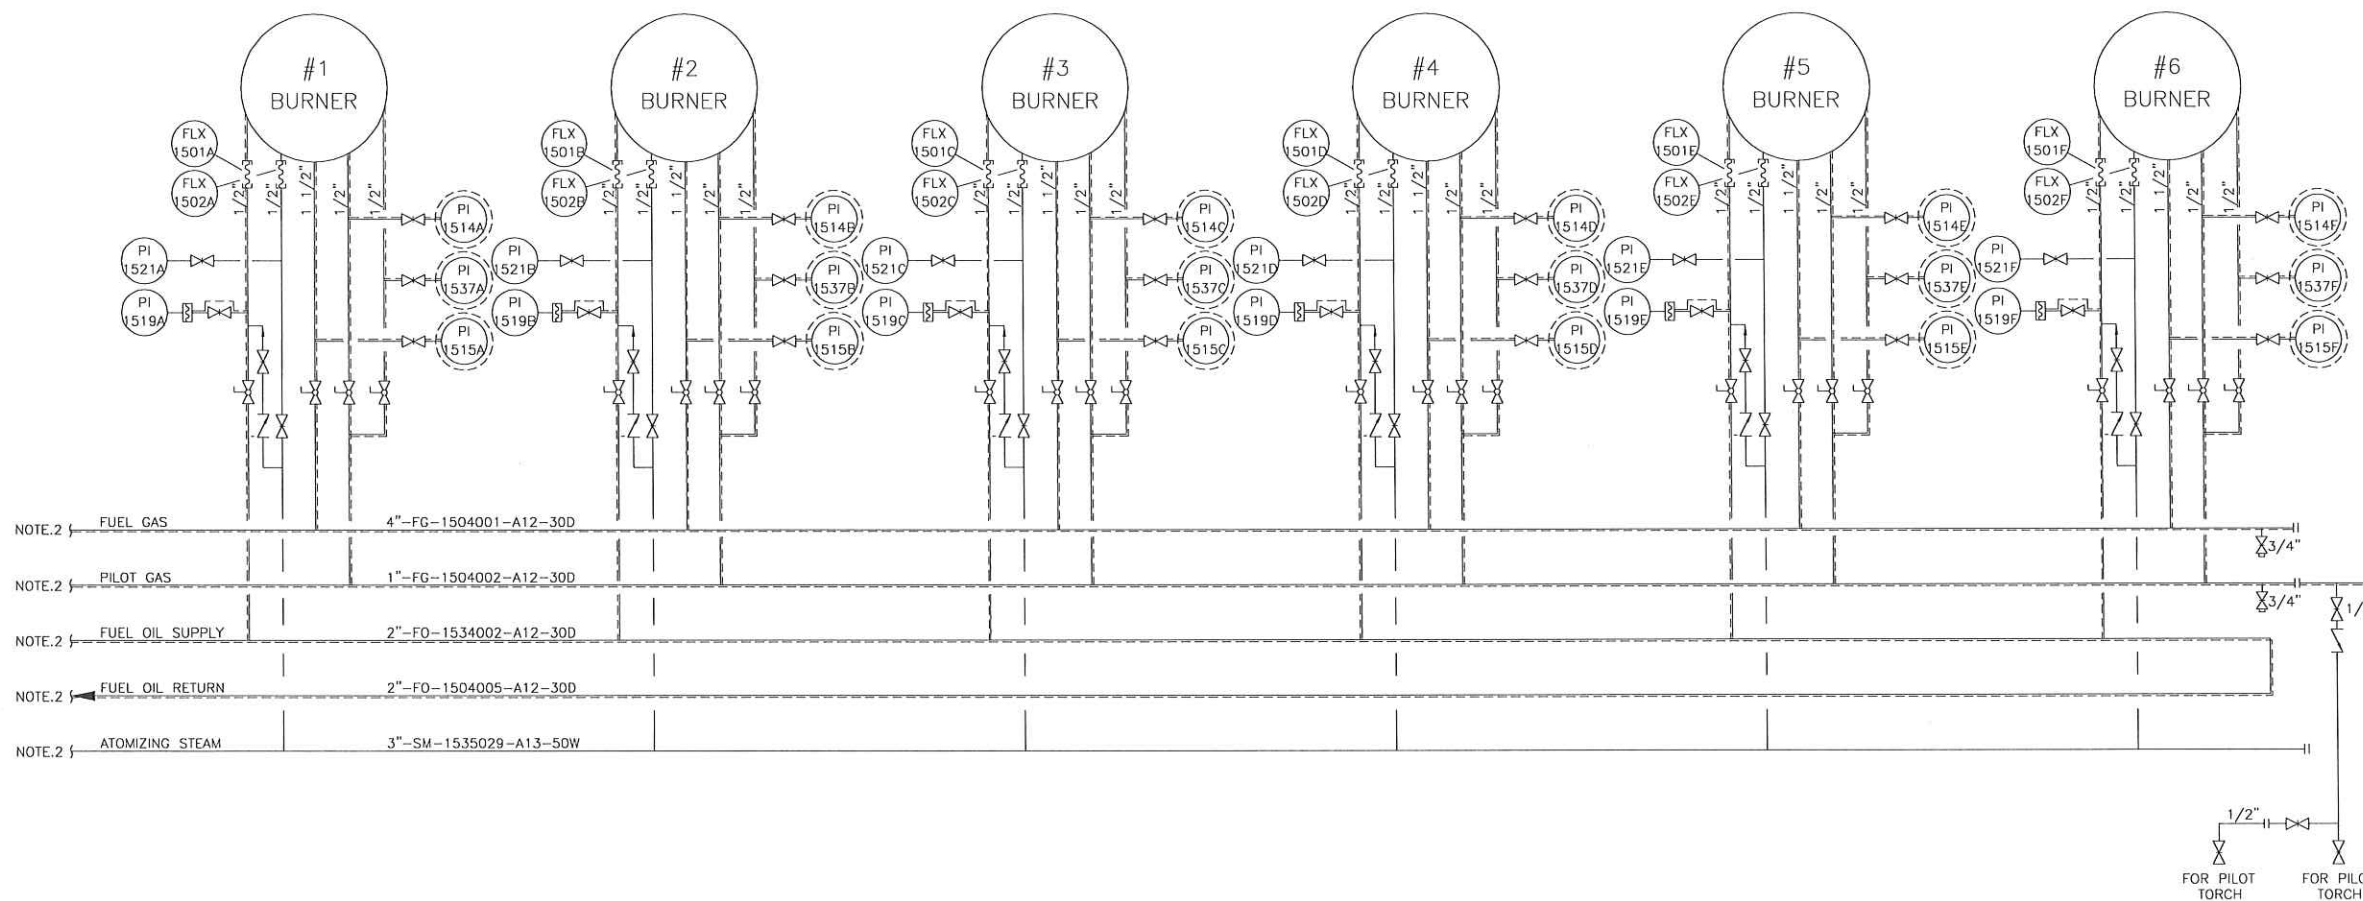

**P&ID AS Built 2021**  
 Issued..... Date **28 JUN 2021**  
 TE Approved..... Date **28 JUN 2021**  
 Area Approved..... Date **29 JUN 2021**

REV.	DATE	DESCRIPTION OF ISSUE	DRWN	CHKD	APPD	APPD
6	09-07-16	UPDATE 2016	NR	ANS		
5	03-14-08	UPDATE 2008	JRW	TN		
4	12-31-98	AS BUILT				
3	11-03-95	REVISED AS MARKED	YSJ	JHS	BYJ	JVL
2	09-07-95	F.F.C	YSJ	JHS	BYJ	JVL
1	08-12-95	A.F.D	YSJ	JHS	BYJ	JVL
0	02-08-95	FOR APPROVAL	TCM	HBS	LEE	

**IRPC**

IRPC PUBLIC COMPANY LIMITED

**TPI SPLITTER PLANT PHASE III PROJECT**  
 RAYONG, THAILAND

**LG Engineering Co., Ltd.**  
 SEOUL, KOREA

**TETRA ENGINEERING & TECHNOLOGY INC.**  
 BRECA, CALIFORNIA, U.S.A.

D/K HDS UNIT PIPING & INSTRUMENT DIAGRAM  
**REACTOR CHARGE HEATER**  
**BURNER PIPING**

JOB NUMBER	DRAWING NUMBER	REV. NO.
8816	69-P-1-15-005-3-6	6