


NOTES:

1. SEE LEGEND AND SYMBOLS DRAWINGS.
2. DELETED.
3. INSTRUMENT NUMBERING ON P&ID SHEETS ARE COMPOSED OF IDENTIFICATION LETTERS, PLANT UNIT NUMBER AND RUNNING NUMBER.

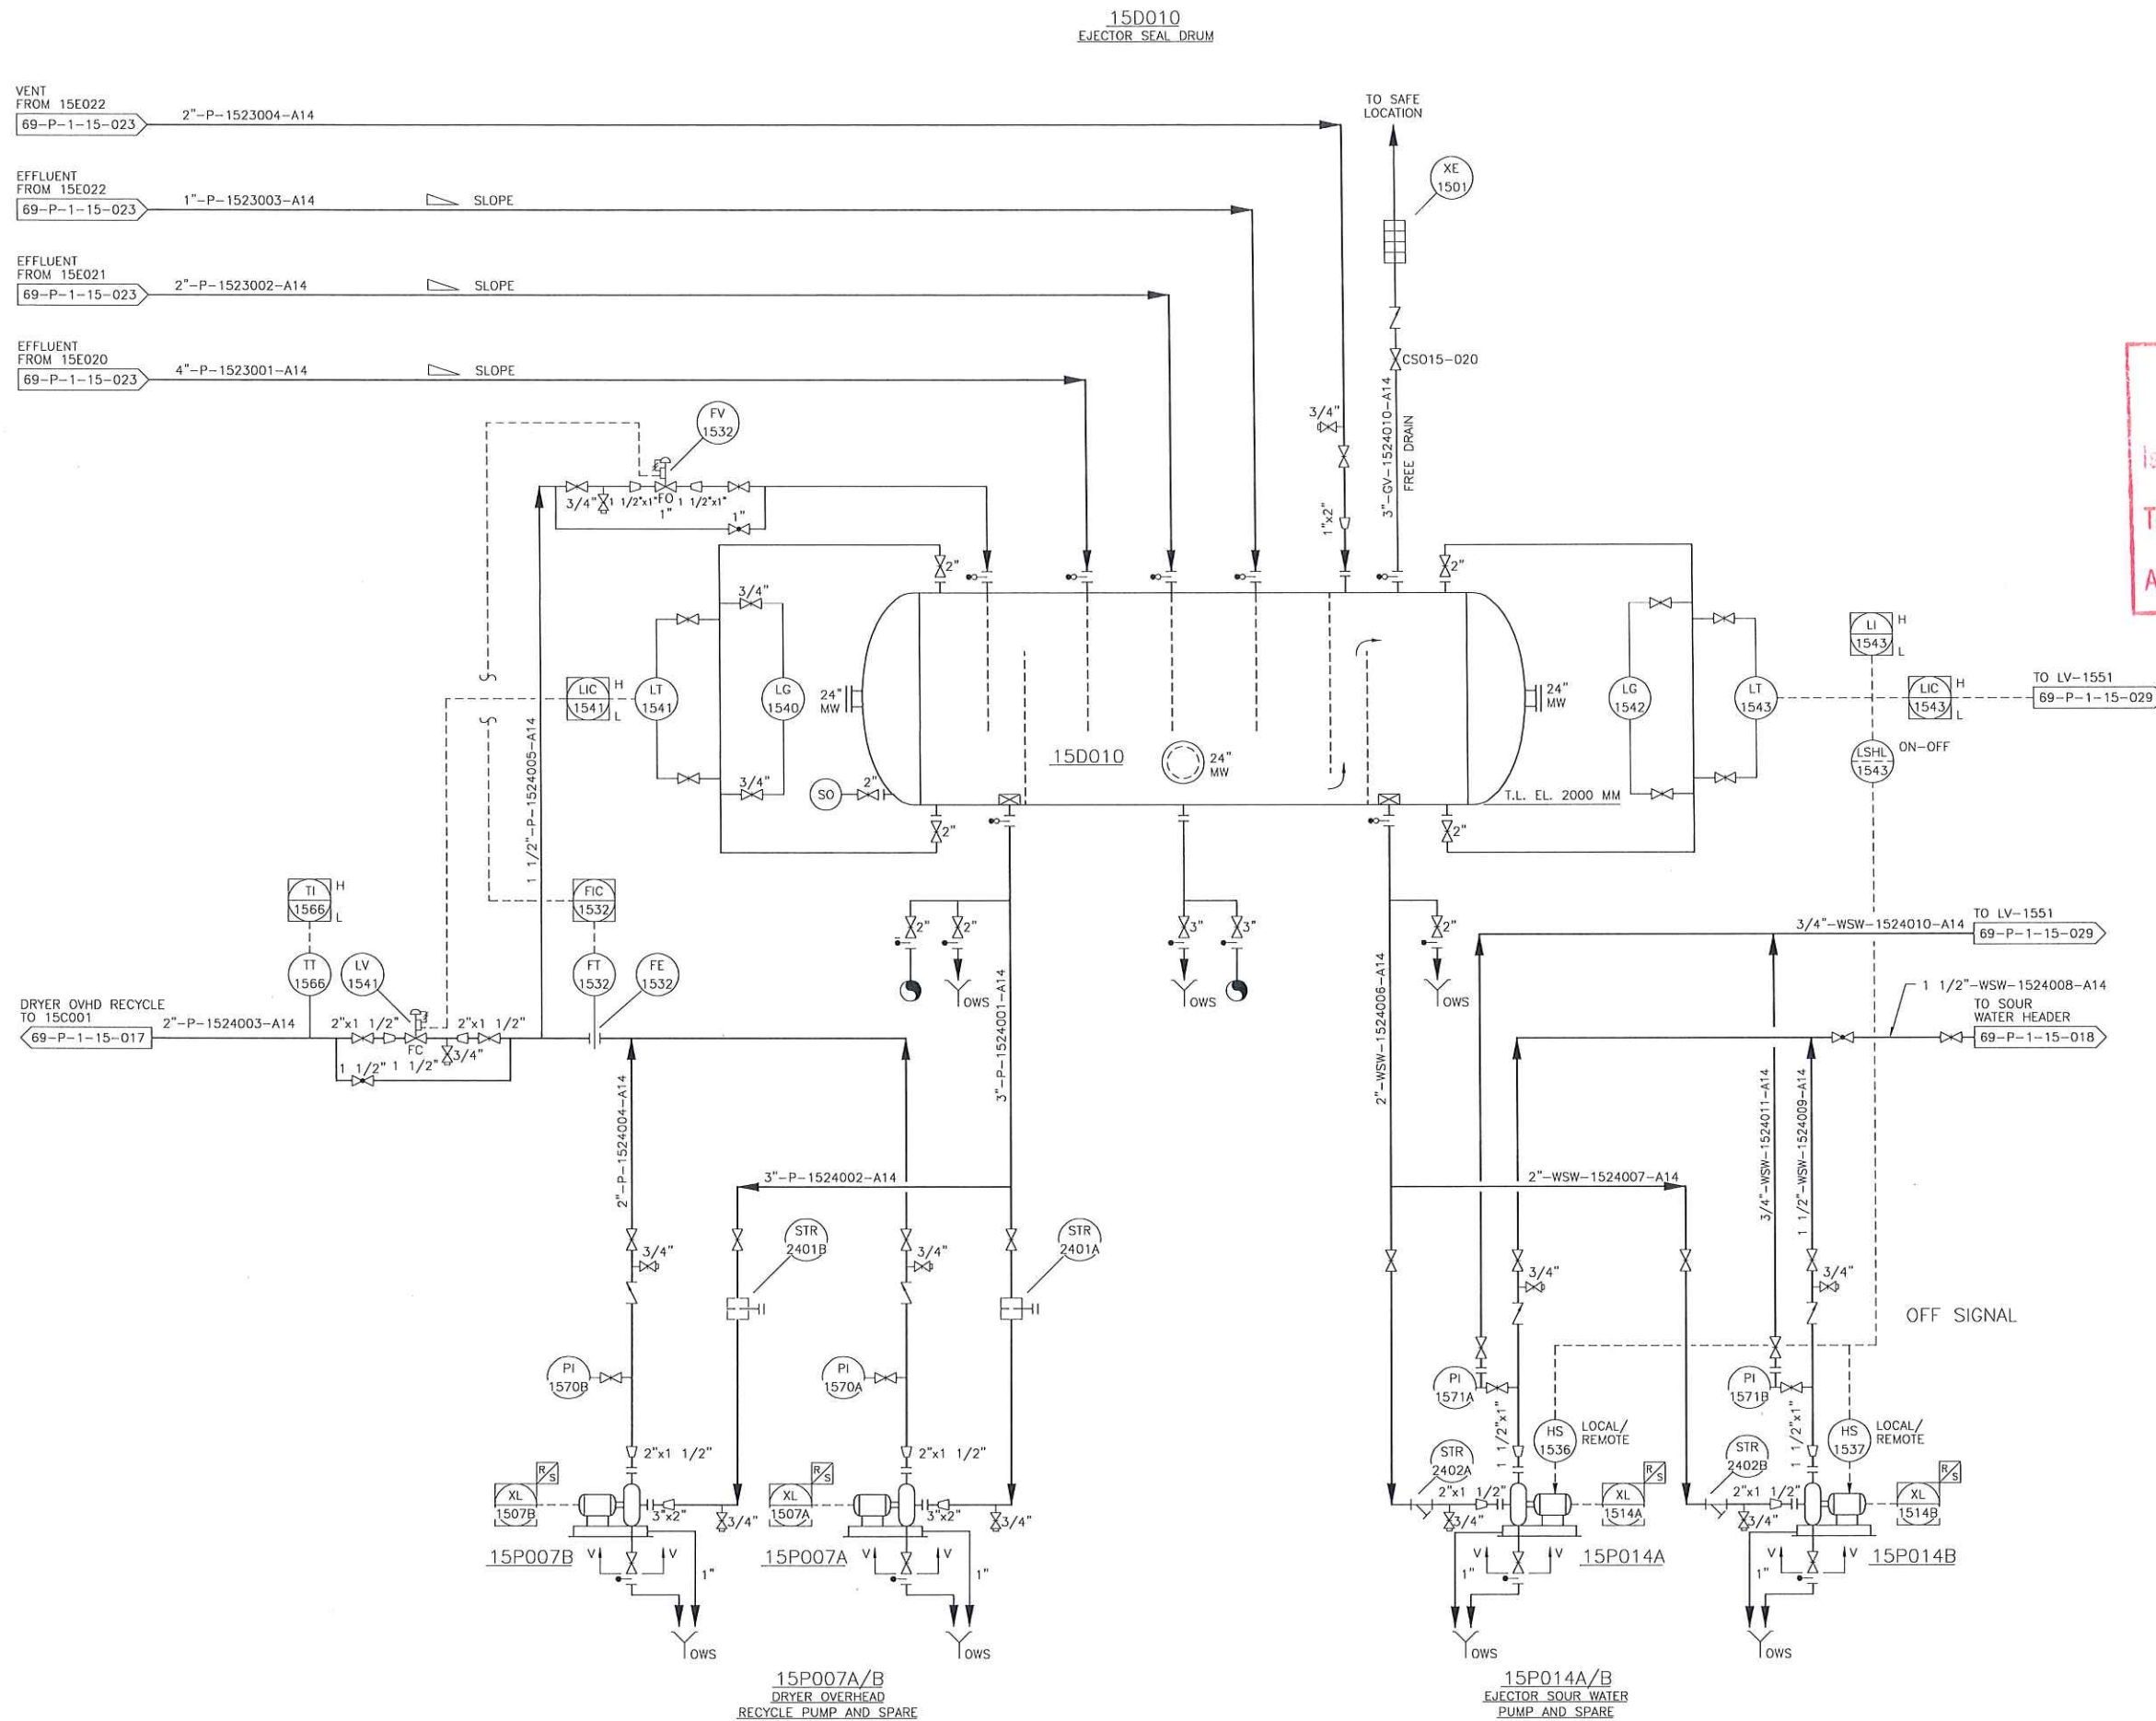

**P&ID AS Built 2021**

Issued: *[Signature]* Date: **28 JUN 2021**

TE Approved: *[Signature]* Date: **28 JUN 2021**

Area Approved: *[Signature]* Date: **29 JUN 2021**

TAG. NO.	LOCATION	REMARK
AE-1506	15P014A/B	GAS DETECTOR

0	6-22-21		UPDATE 2021		NR	KTN			
9	03-06-18		UPDATE 2018		NR	PKR			
8	09-09-16		UPDATE 2016		NR	ANS			
7	03-26-15		UPDATE 2015		NR	ANS			
6	06-26-14		1/2" DIS. 15P014A/B TO LV-1551		NR	ANS			
5	03-14-08		UPDATE 2008		JRW	TN			
4	12-31-96		AS BUILT						
3	11-03-95		REVISED AS MARKED		YSJ	JHS	BYJ	JWL	
2	08-12-95		F.F.C		YSJ	JHS	BYJ	JWL	
1	03-31-95		A.F.D.		YSJ	JHS	KK YSK	MHS GHK	
0	02-08-95		FOR APPROVAL		TCM	HBS	LEE		
REV.	DATE		DESCRIPTION OF ISSUE		DRWN	CHKD	APPD	APPD	APPD



IRPC PUBLIC COMPANY LIMITED

TPI SPLITTER PLANT PHASE III PROJECT  
RAYONG, THAILAND

**LG Engineering Co., Ltd.**  
SEOUL, KOREA



**TETRA ENGINEERING &  
TECHNOLOGY INC.**  
BREA, CALIFORNIA, U.S.A.

D/K HDS UNIT
--------------

PIPING & INSTRUMENT DIAGRAM

EJECTOR SEAL DRUM

JOB NUMBER	DRAWING NUMBER	REV. NO.
8816	69-P-1-15-024-3-10	10