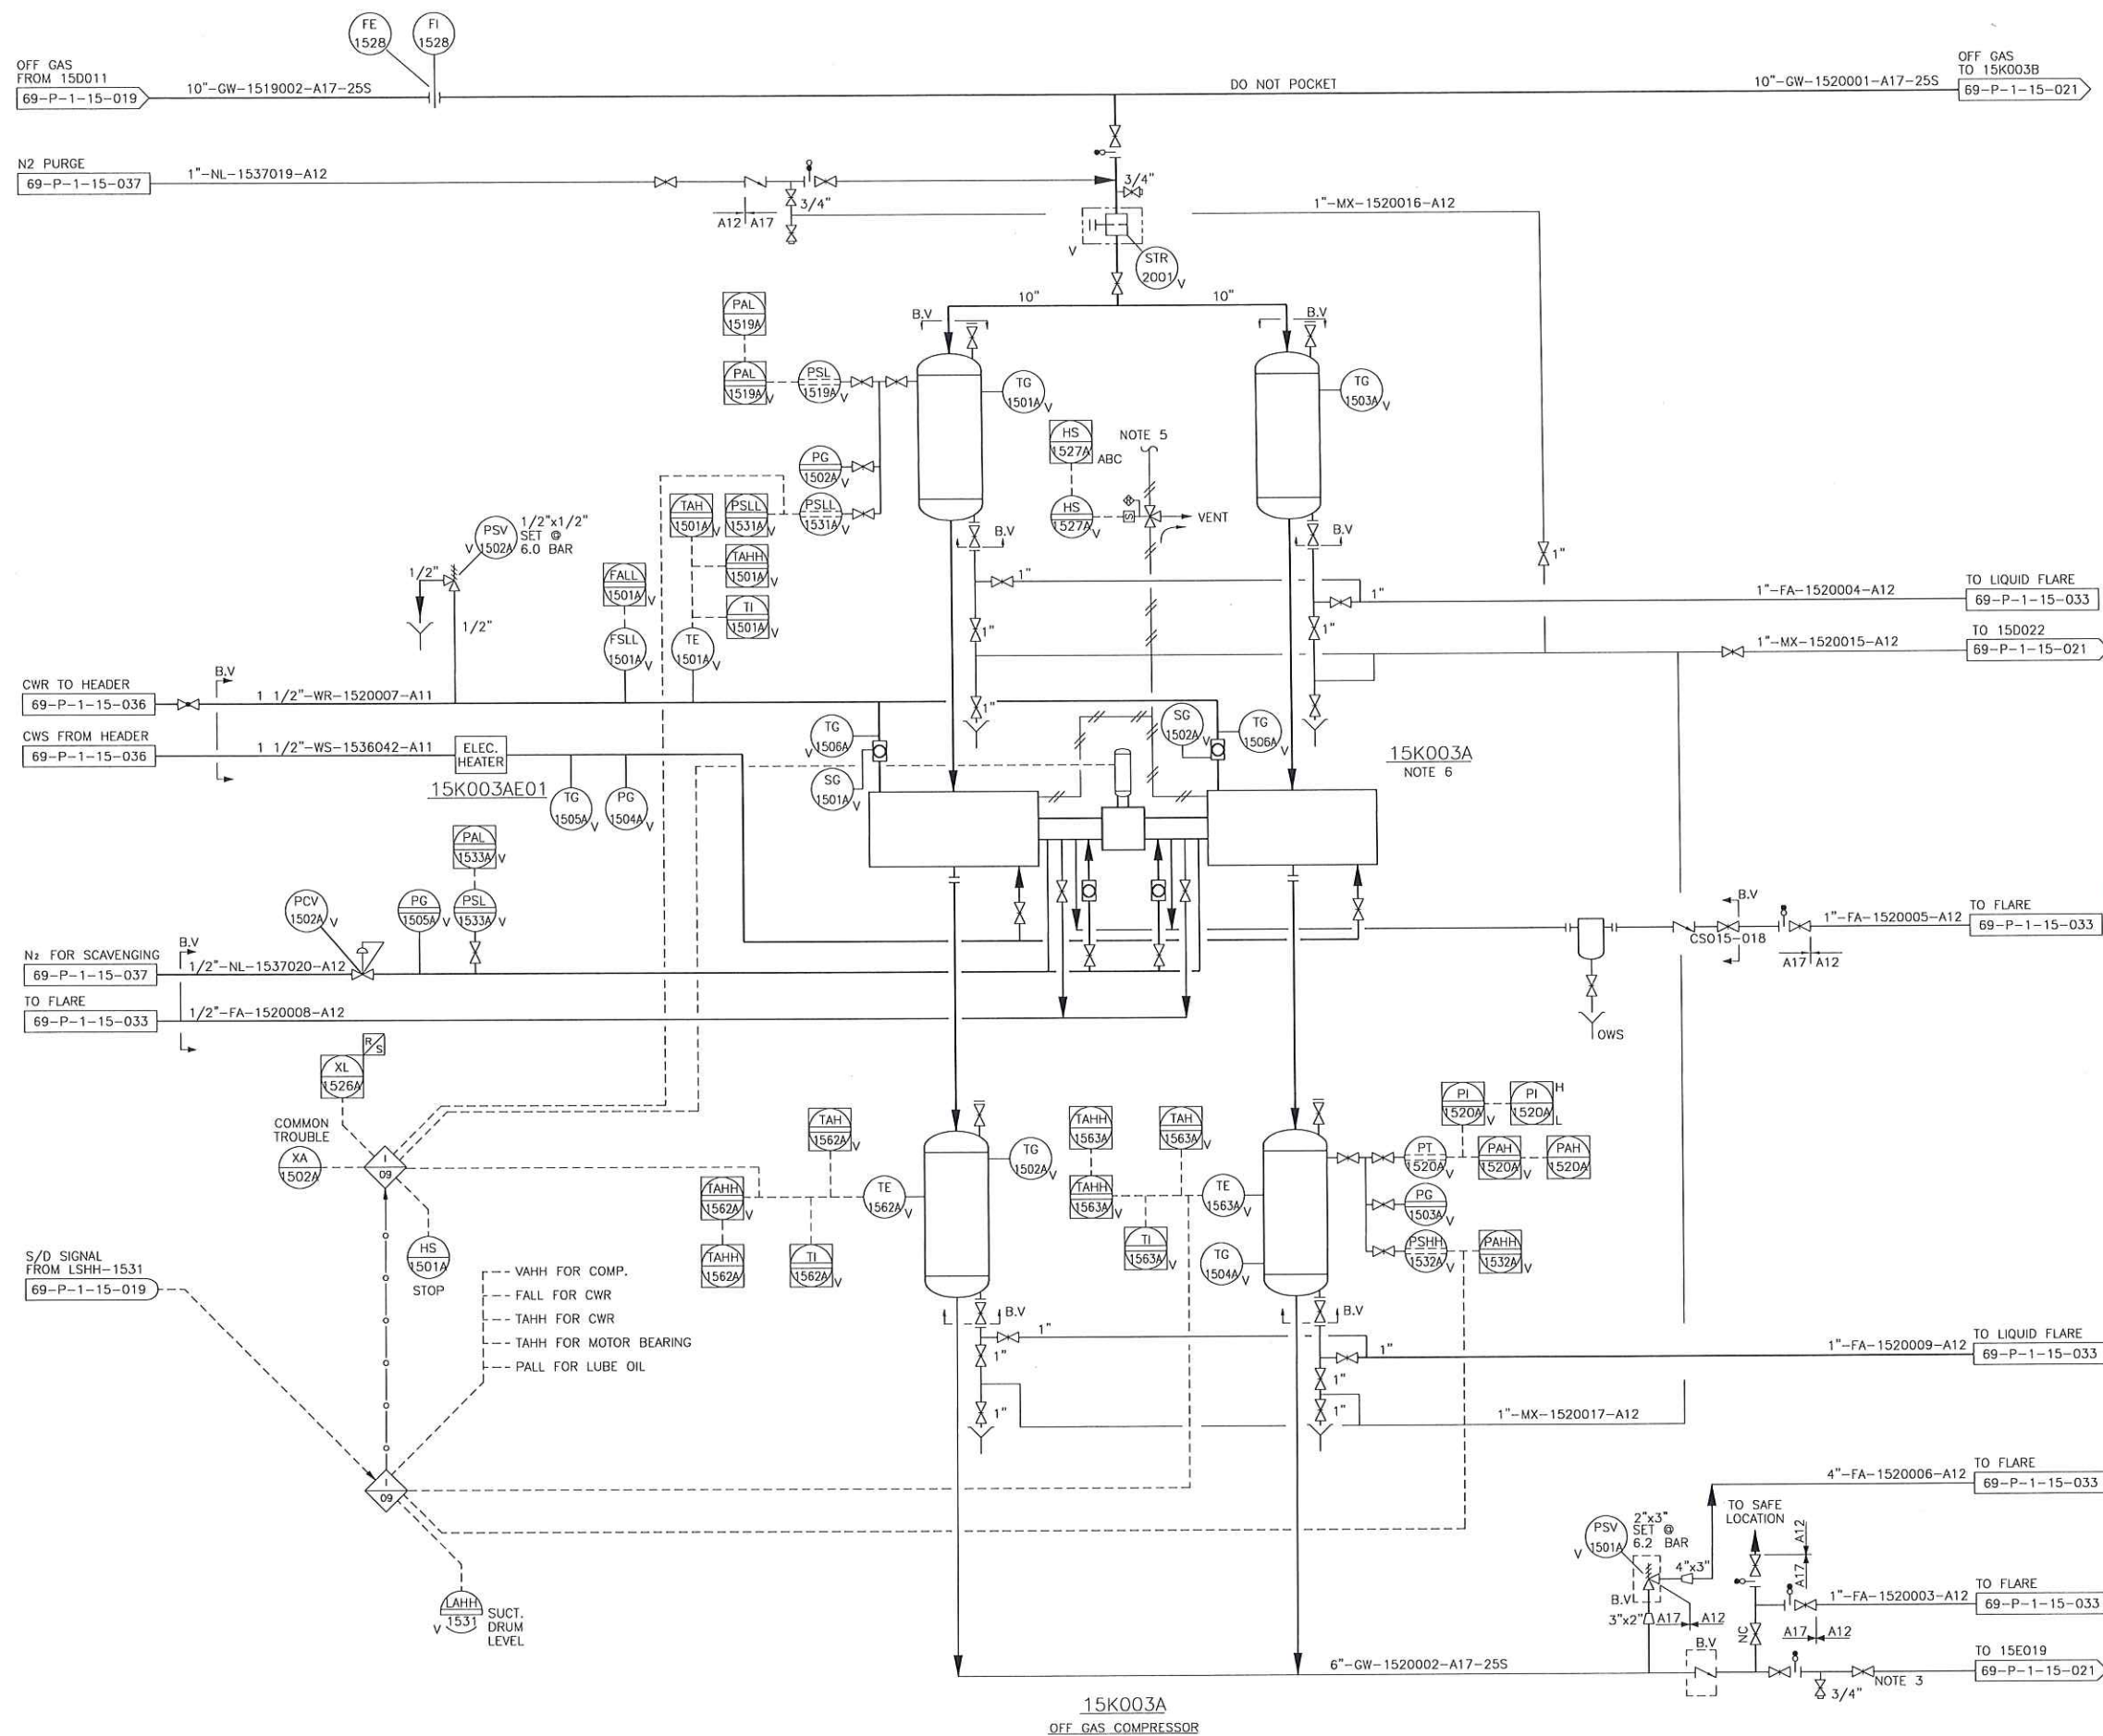


C.W. ELECTRIC HEATER  
15K003AE01

## NOTES:

1. SEE LEGEND AND SYMBOLS DRAWINGS.
2. DELETED.
3. INTERCONNECTION PIPING TO BE SIZED BY COMPRESSOR VENDOR.
4. INSTRUMENT NUMBERING ON P&ID SHEETS ARE COMPOSED OF IDENTIFICATION LETTERS, PLANT UNIT NUMBER AND RUNNING NUMBER.
5. 3 STEPS OF CAPACITY CONTROL (0%, 50%, 100%).
6. SEE VENDOR P&ID DWG NO. 15-R-K-05-001 FOR COMPRESSOR MECHANICAL & CONTROL DETAILS.

**P&ID AS Built 2021**  
 Issued: *gmm* Date: **2.8 JUN 2021**  
 TE Approved: *gmm* Date: **2.8 JUN 2021**  
 Area Approved: *gmm* Date: **2.9 JUN 2021**

TAG. NO.	LOCATION	REMARK
AE-1507	15K003A/B	GAS DETECTOR

REV.	DATE	DESCRIPTION OF ISSUE	DRWN	CHKD	APPD	APPD	APPD
06-23-21		UPDATE 2021	NR	KTN			
01-08-19		UPDATE 2019	NR	KTN			
03-14-08		UPDATE 2008	JRW	TN			
12-31-96		AS BUILT					
01-29-96		REVISED AS MARKED	YSJ	JHS	BYJ	JML	
11-03-95		REVISED AS MARKED	YSJ	JHS	BYJ	JML	
09-07-95		F.F.C	YSJ	JHS	BYJ	JML	
08-12-95		A.F.D	YSJ	JHS	BYJ	JML	
02-08-95		FOR APPROVAL	TCM	HBS	LEE		

**IRPC**

IRPC PUBLIC COMPANY LIMITED

TPI SPLITTER PLANT PHASE III PROJECT  
RAYONG, THAILAND**LG Engineering Co., Ltd.**  
SEOUL, KOREA**TETRA ENGINEERING & TECHNOLOGY INC.**  
BREA, CALIFORNIA, U.S.A.D/K HDS UNIT PIPING & INSTRUMENT DIAGRAM  
OFF GAS COMPRESSOR  
15K003A

JOB NUMBER	DRAWING NUMBER	REV. NO.
8816	69-P-1-15-020-3-8	8