


API SEAL PLAN 11

AUX
61

C/W PIPING PLAN

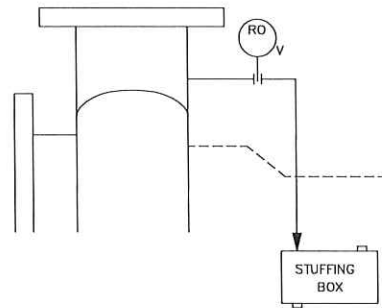


PUMP NO.	RO NO.	PUMP NO.	RO NO.
15P002A/B	RO-152605A/B	15P015A/B	RO-153921A/B
15P005A/B	RO-151806A/B		
15P006A/B	RO-152207A/B		
15P007A/B	RO-152408A/B		
15P008A/B	RO-153017A/B		
15P013A/B	RO-153218A/B		
15P014A/B	RO-152419A/B		

API SEAL PLAN 11

AUX
52


C/W PIPING PLAN

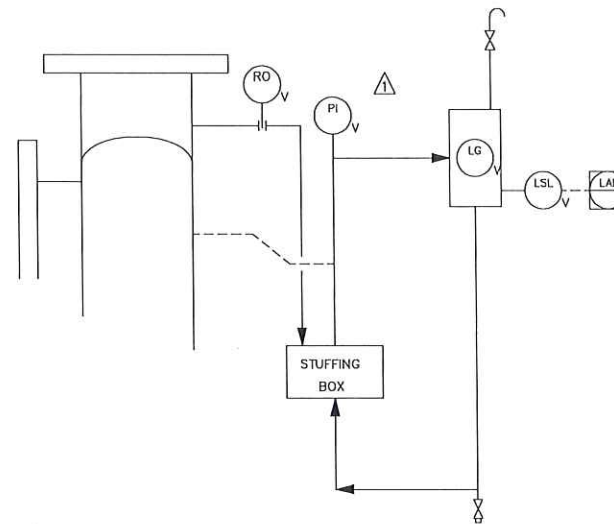

PUMP NO.	RO NO.	LG NO.	LS NO.	PI NO.
15P009A/B	RO-151823A/B	LG-151806A/B	LSL-151910A/B	PI-151861A/B

NOTES:


API SEAL PLAN 11

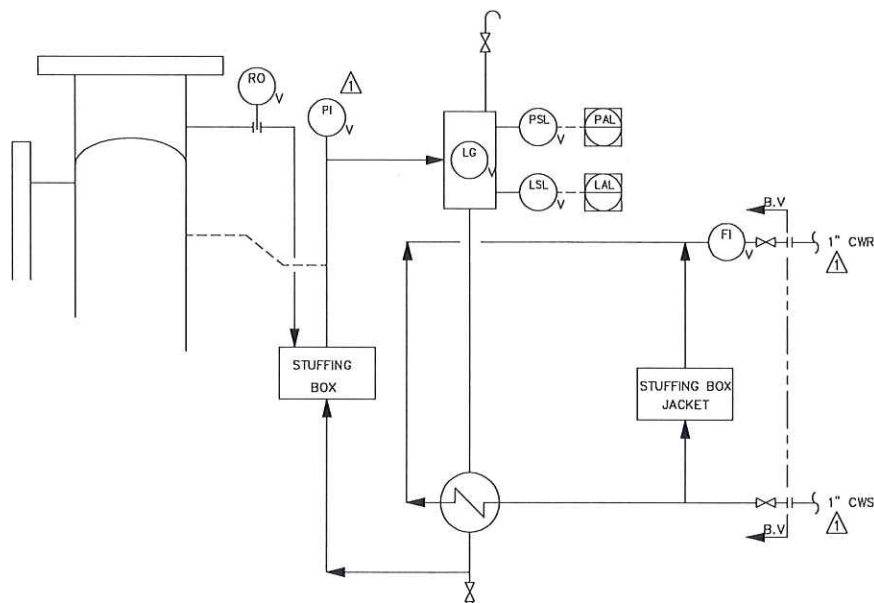AUX
52C/W PIPING PLAN
J

PUMP NO.	RO NO.	LG NO.	LS NO.	FI NO.	FI NO.	PI NO.
15P001A/B	RO-150222A/B	LG-150205A/B	LSL-150219A/B	FI-150208A/B	PSL-150242A/B	PI-150207A/B

API SEAL PLAN 53

AUX

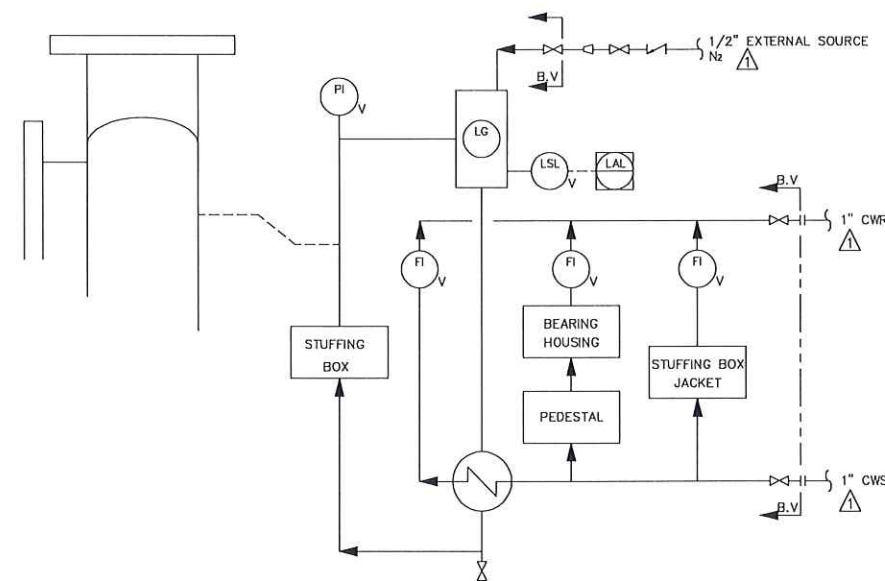C/W PIPING PLAN
L

PUMP NO.	PI NO.	LG NO.	LS NO.	FI NO.	FI(BEARING)	FI(STUFFING)
15P003A/B/C	PI-151732A/B/C	LG-151707A/B/C	LSL-151713A/B/C	FI-151713A/B/C	FI-151754A/B/C	FI-151755A/B/C
15P004A/B	PI-152733A/B	LG-152709A/B	LSL-152716A/B	FI-152752A/B	FI-152756A/B	FI-152757A/B

P&ID AS Built 2021
 Issued... Date 28 JUN 2021
 TE Approved... Date 28 JUN 2021
 Area Approved... Date 29 JUN 2021

REV.	DATE	DESCRIPTION OF ISSUE	DRWN	CHKD	APPD	APPD	APPD
03-14-08		UPDATE 2008	NR	TH			
07-03-00		ACCESSORIES OF SEAL PLAN FOR 15P003C	NR				
11-03-95		REVISED AS MARKED					
08-12-95		F.F.C	YSJ	JHS	BYJ	JML	

IRPC

IRPC PUBLIC COMPANY LIMITED

TPI SPLITTER PLANT PHASE III PROJECT
RAYONG, THAILAND**LG Engineering Co., Ltd.**
SEOUL, KOREA**TETRA ENGINEERING & TECHNOLOGY INC.**
BREA, CALIFORNIA, U.S.A.D/K HDS UNIT PIPING & INSTRUMENT DIAGRAM
PUMP SEAL FLUSH AND COOLING WATER PLAN

JOB NUMBER	DRAWING NUMBER	REV. NO.
8816	69-P-1-00-405-3-3	3