


NOTES

- SEE LEGEND AND SYMBOLS DRAWINGS.
- INSTRUMENT NUMBERING ON P&ID SHEETS ARE COMPOSED OF IDENTIFICATION LETTERS, PLANT UNIT NUMBER AND RUNNING NUMBER.
- SEE TYPICAL UTILITY STATION DETAIL ON DEG. 69-P-1-15-036.
- USE EXISTING VALVE.
- NEW VALVE.

PAID AS Built 2021

Issued... *mya* Date 28 JUN 2021
 TE Approved... *[Signature]* Date 28 JUN 2021
 Area Approved... *[Signature]* Date 29 JUN 2021

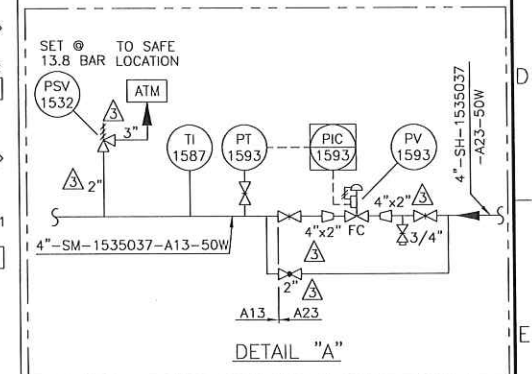

REV.	DATE	DESCRIPTION	DRN	CHKD	APPD	APPD
14	06-23-21	UPDATE 2021	NR	KTN		
13	06-29-20	UPDATE 2020	NR	KTN		
12	07-10-19	UPDATE 2019	NR	KTN		
11	05-09-17	UPDATE 2017	NR	ANS		
10	12-22-16	IMPROVE FG REFINERY	NR	ANS		
9	03-26-15	UPDATE 2015	NR	ANS		
8	03-12-12	UPDATE 2012	NR	ANS		
7	12-20-10	INSTALL CONDENSATE FLASH DRUM	NR	SR		
6	03-14-08	UPDATE 2008	JRW	TN		
5	11-05-01	UPDATE 2001	NR			
		DESCRIPTION	DRN	CHKD	APPD	APPD

IRPC IRPC PUBLIC COMPANY LIMITED TPI SPLITTER PLANT PHASE III PROJECT RAYONG, THAILAND					
LG Engineering Co., Ltd. SEOUL, KOREA					
TETRA TETRA ENGINEERING & TECHNOLOGY INC. BREA, CALIFORNIA, U.S.A.					
UTILITY FLOW DIAGRAM STEAM & CONDENSATE SYSTEM					
SQUAD CHECK					
PROCESS	PIPING	VESSLS	STRUCT.	ELEC.	INST.
DWG. NO. 69-P-1-15-035-3-14					
SCALE	NONE	JOB NO.	8816	MICROFILM NO.	